


T.8S. R.39E. W.M.

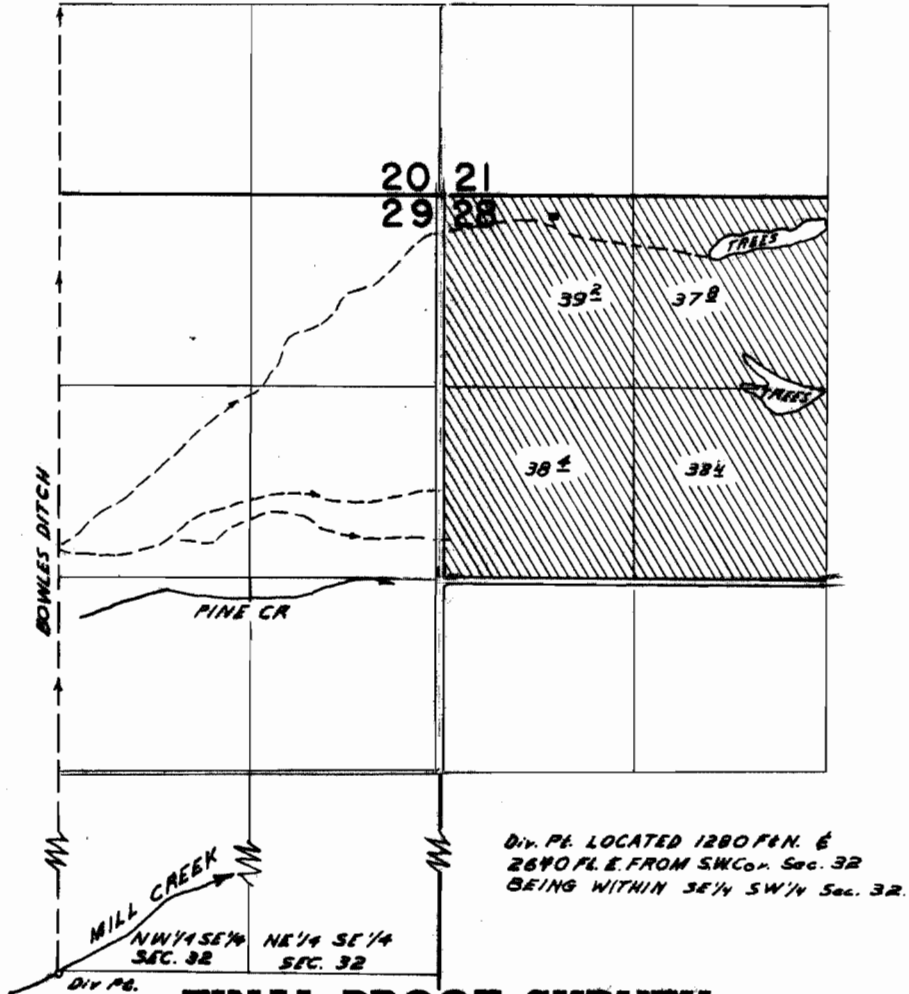

FINAL PROOF SURVEY
UNDER

Application No. 34540 Permit No. 27123
IN NAME OF

WILLIAMS DITCH CO.

Surveyed NOV. 17 1964, by C. GARDNER