


T.14S. R.5W. W.M.

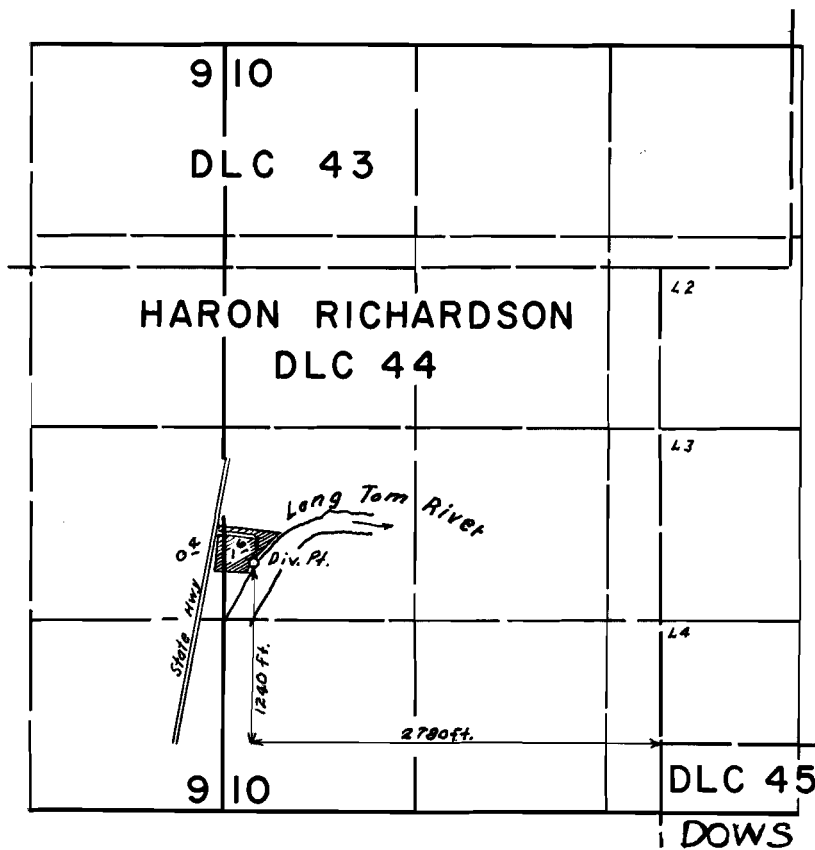

**FINAL PROOF SURVEY**  
UNDER

Application No. 40371 Permit No. 30099  
IN NAME OF

FRED or HAZEL CLEVELAND

Surveyed Oct 1, 1965, by Clayton J. Gardner