


T.14S.R.5W.W.M.

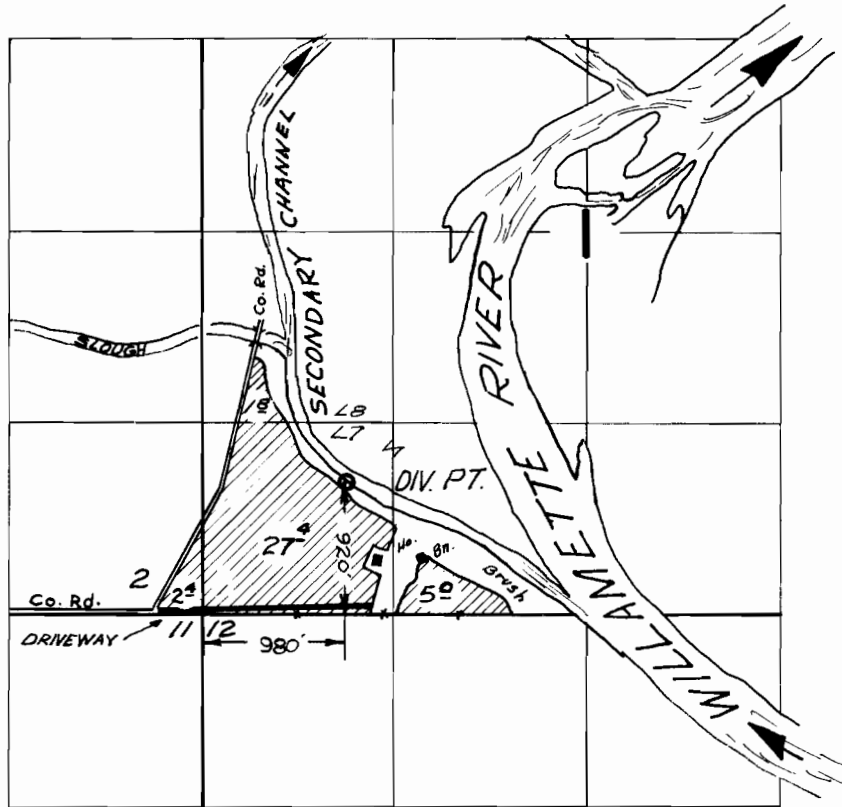

FINAL PROOF SURVEY UNDER

Application No. 37879... Permit No. 28230
IN NAME OF

.....WILLIAM J. DONOVAN.....

Surveyed April 25 1966, by V. GARNER.....