


T.13S.R.5W. W.M.

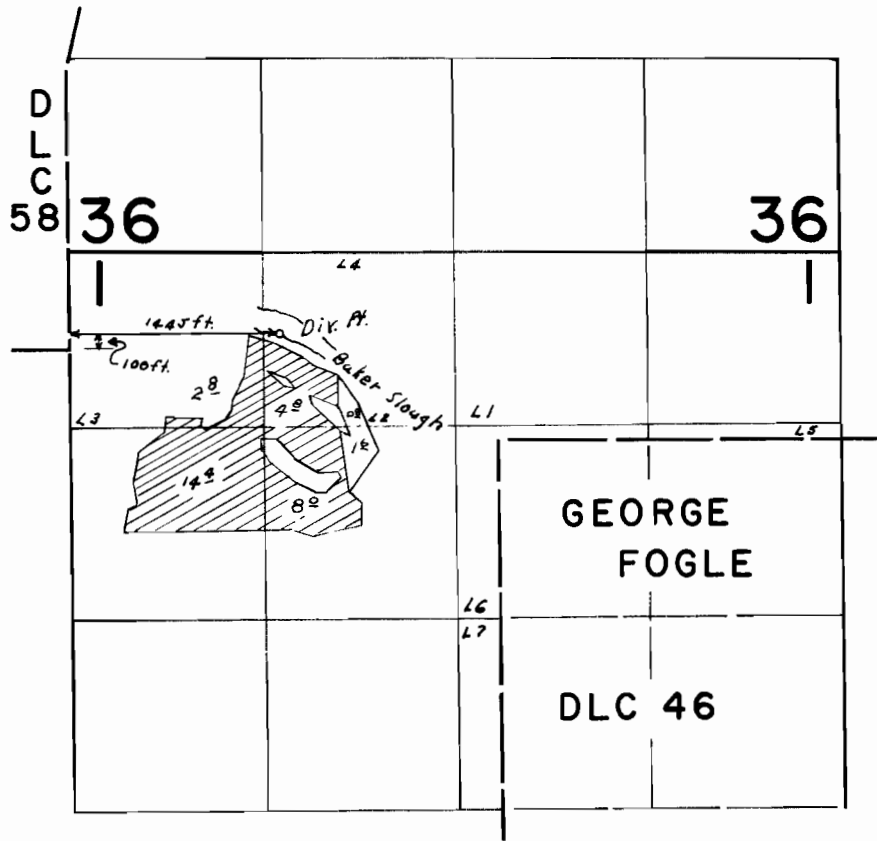

FINAL PROOF SURVEY
UNDER

Application No. 32431 Permit No. 25602
IN NAME OF

ROSE M. LOVELADY

Surveyed Sept. 30, 1965, by Clayton J. Gardner