


T. 27 S. R. 11 W. W. M.

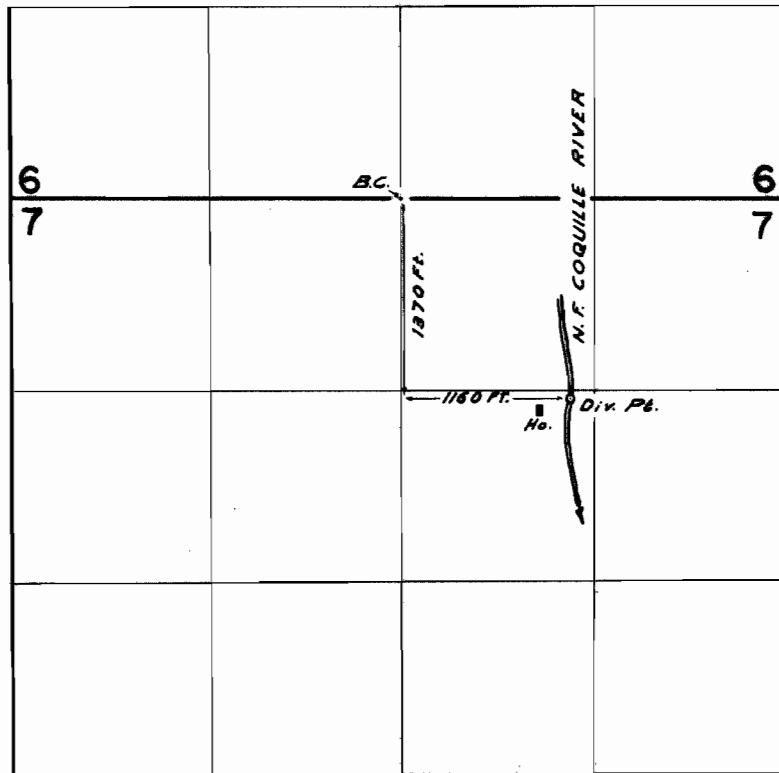

FINAL PROOF SURVEY
UNDER

Application No. 39674 Permit No. 29619
IN NAME OF

LENA M. DUNLAP

Surveyed AUG. 26, 1965, by L. COLEBANK