


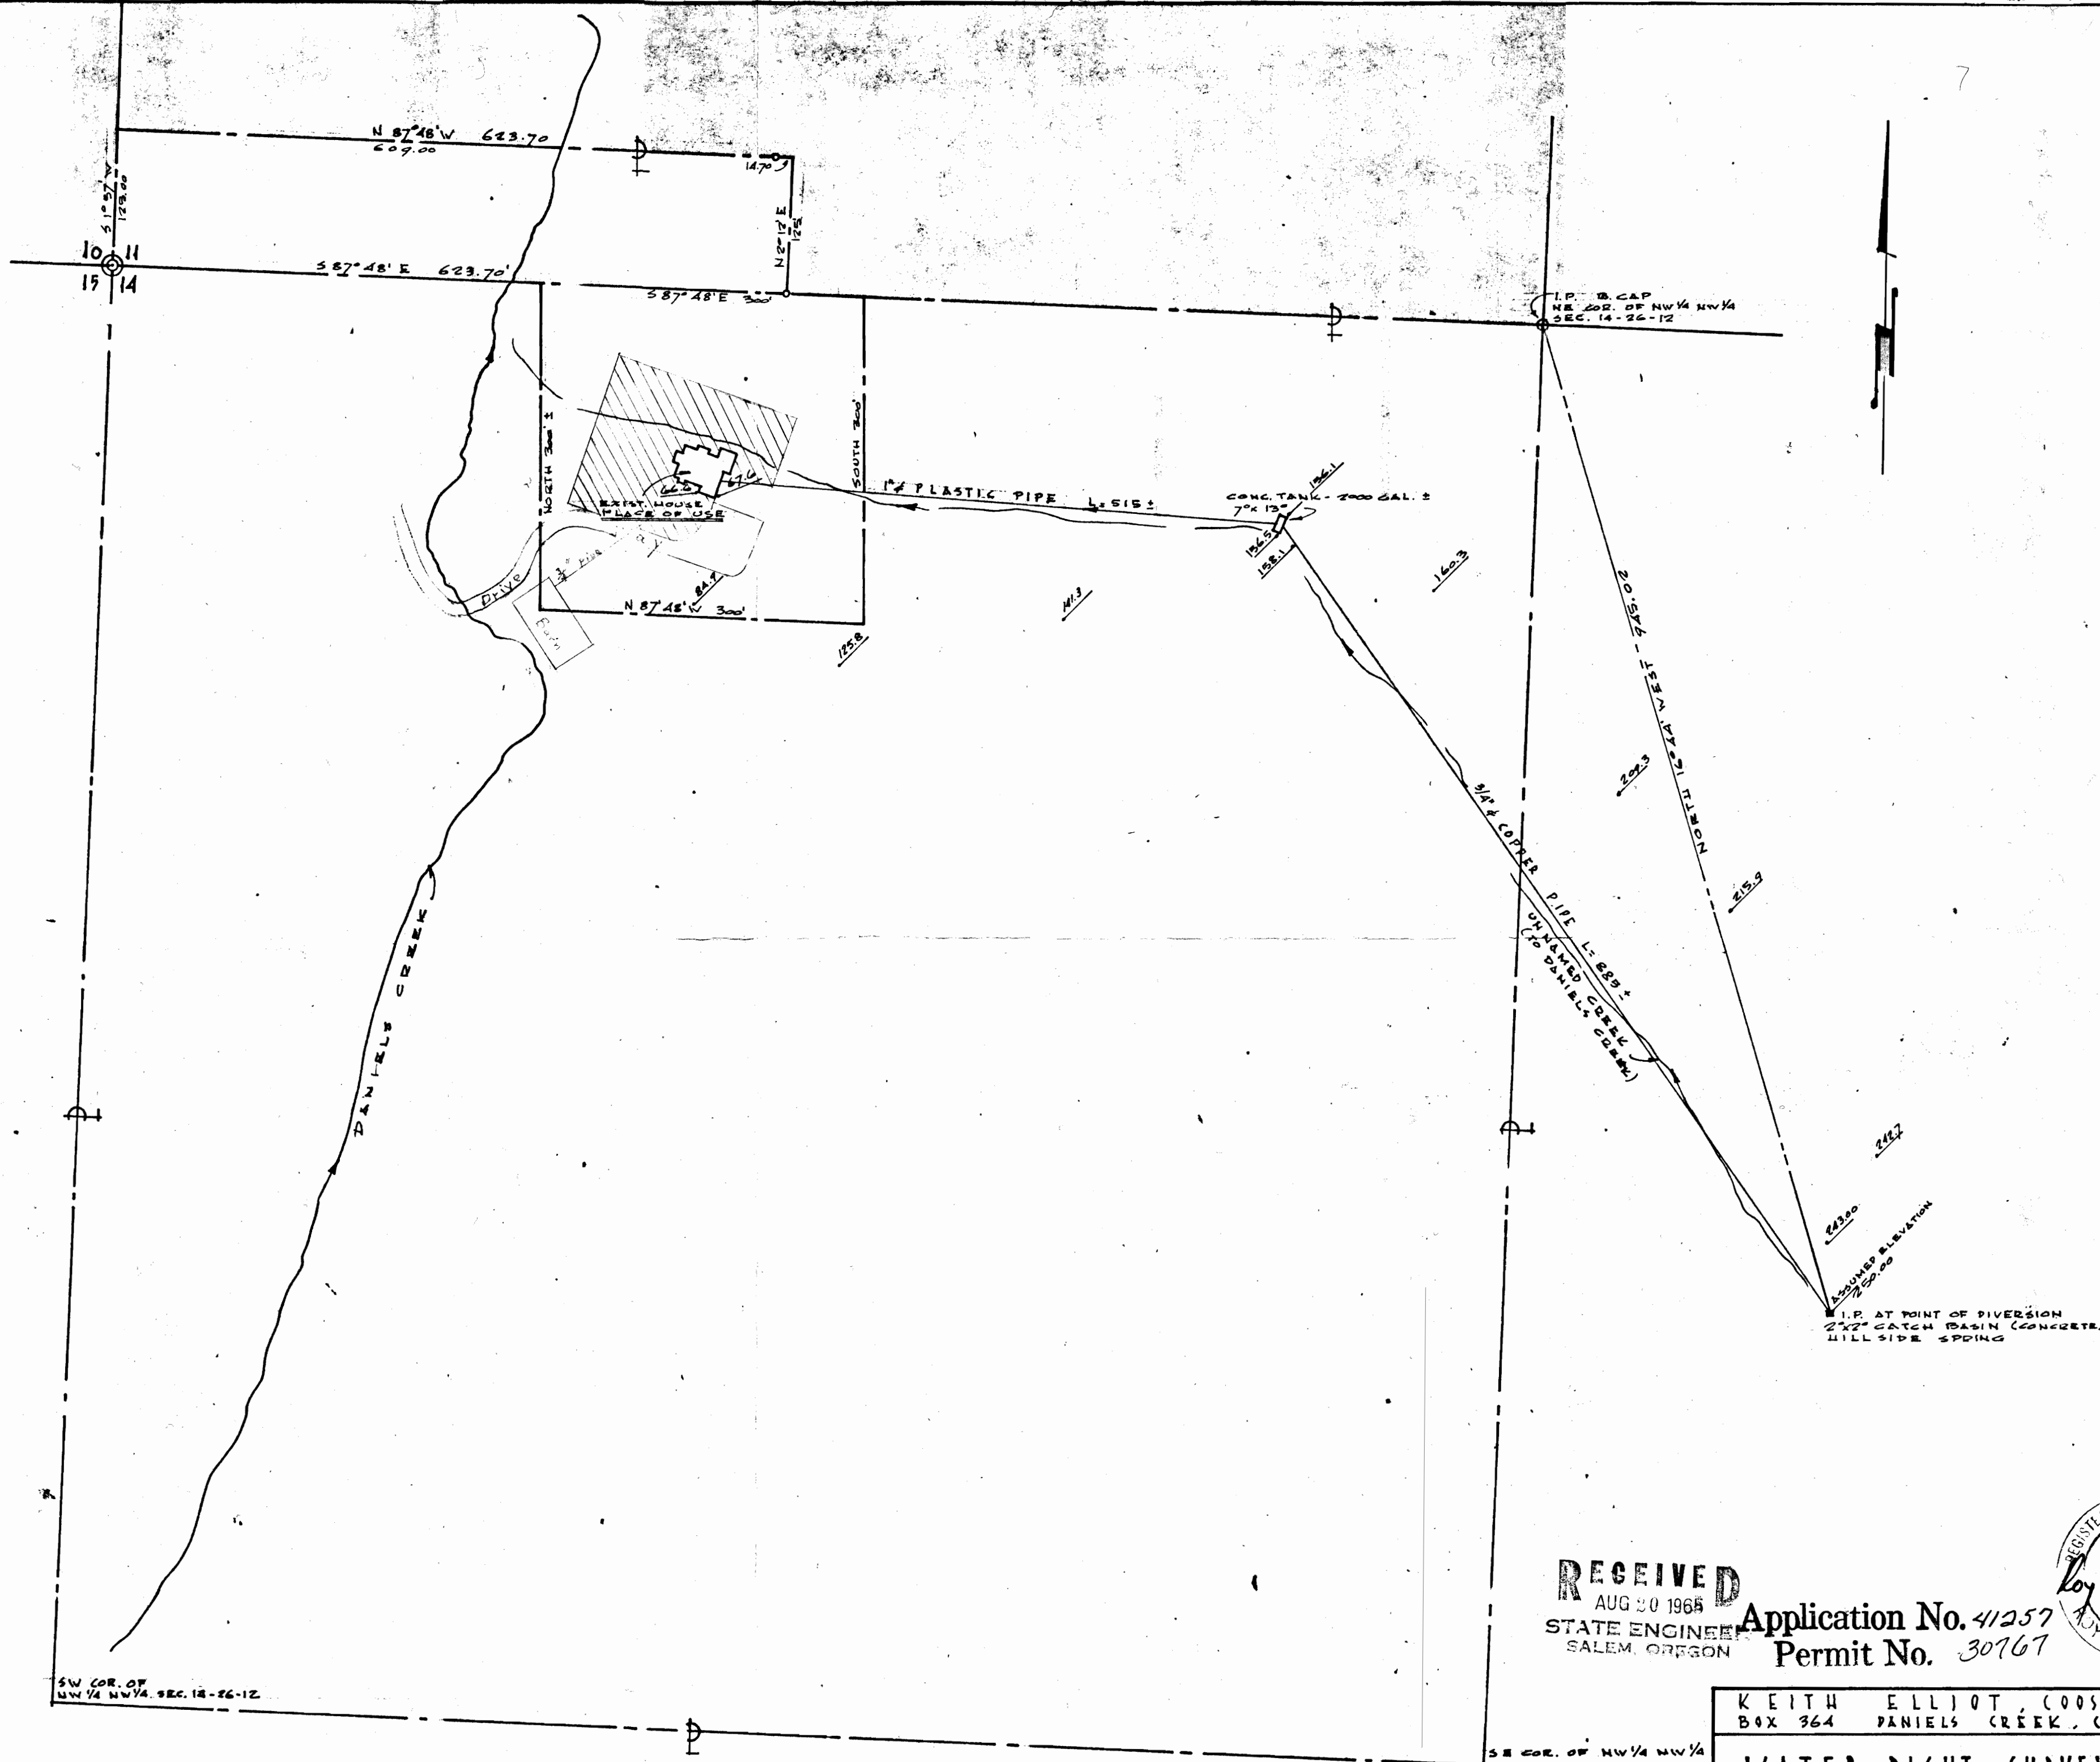

RECEIVED
AUG 20 1965
STATE ENGINEER
SALEM, OREGON

Application No. 41257
Permit No. 30767



KEITH ELLIOT, COOS RIVER ROUTE BOX 364 DANIELS CREEK, COOS COUNTY OREGON	
WATER RIGHT SURVEY	
R. H. ERICSEN & ASSOCIATES CONSULTING ENGINEERS COOS BAY OREGON	SCALE: 1" = 100' DATE: 8-14-65
PROJECT 754-B-65	1