


T.27S.R.12W.W.M.

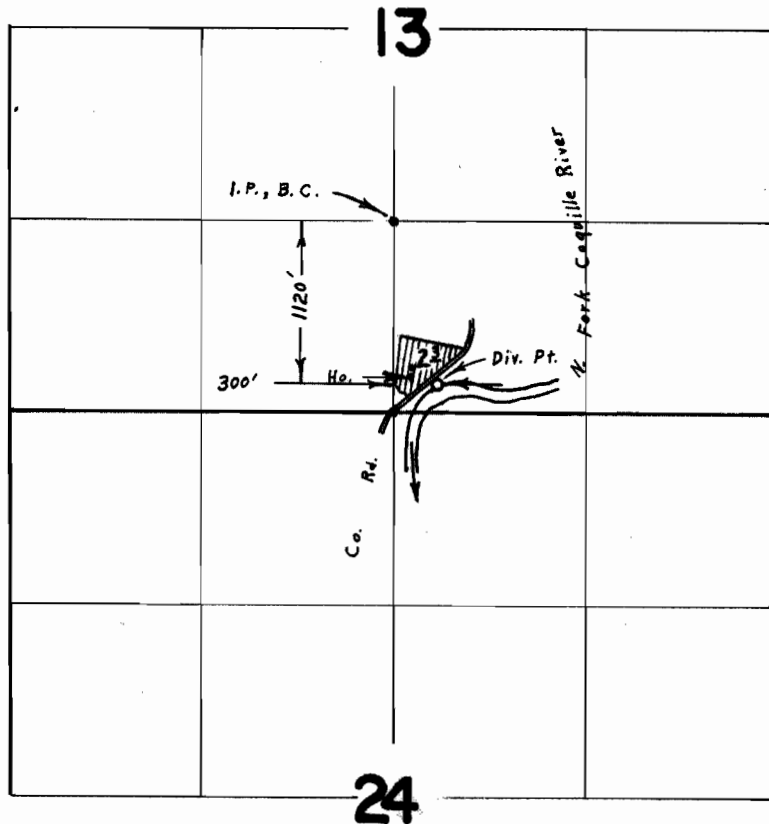

FINAL PROOF SURVEY
UNDER

Application No. 39496 Permit No. 29317
IN NAME OF

LESTER THOMAS GARRISON

Surveyed Oct. 7, 1966, by L. E. Gould