


T.28S. R.12W. W.M.

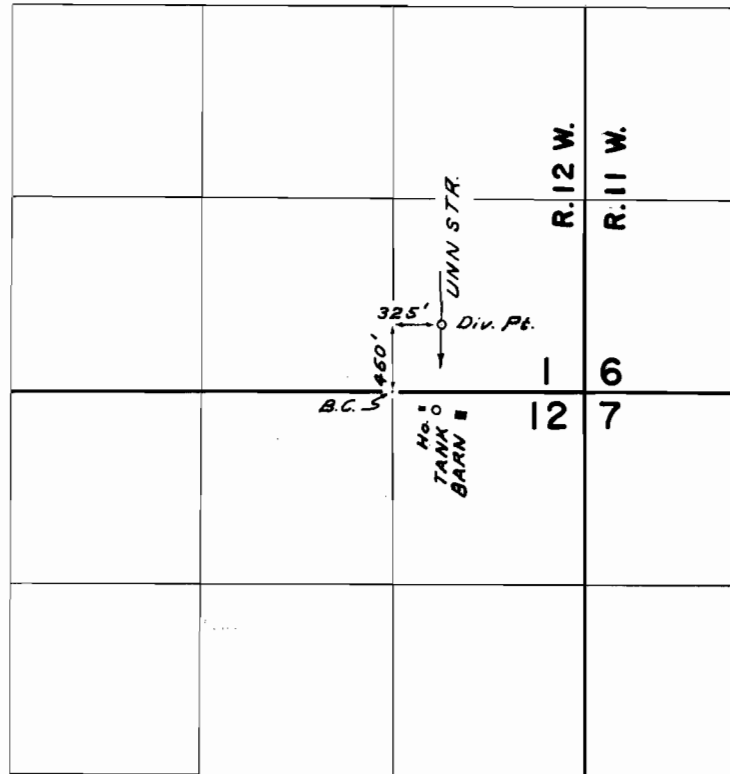

**FINAL PROOF SURVEY**  
UNDER

Application No. 37081 Permit No. 27605  
IN NAME OF

MYRTLE CAMPBELL & ADAM HEISTAND

Surveyed AUG. 28 1965 by L. COLEBANK