


T. 28S. R. 12 W. W.M.

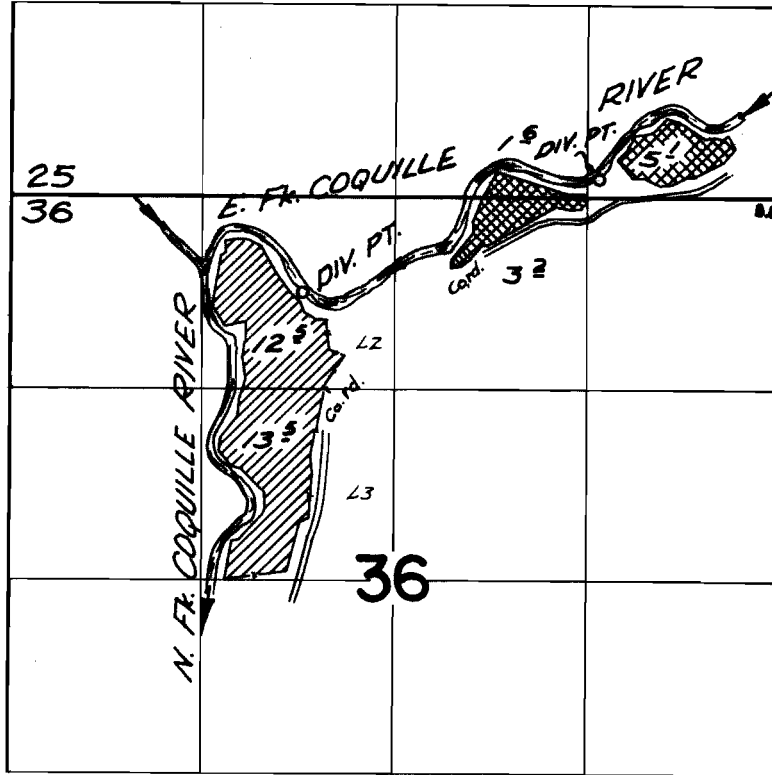

Div. Pts. located 660 ft. S. & 3270 ft. W.; 130 ft. N. & 1240 ft. W.
both from the Northeast corner of Section 36

FINAL PROOF SURVEY UNDER

33570 26560
Application No. ~~40239~~ Permit No. 30048 
IN NAME OF 

JOHNNY JAMES KNIGHT

Surveyed Oct. 8, 1966, by V. GARNER