


T. 28S. R. 12 W. W.M.

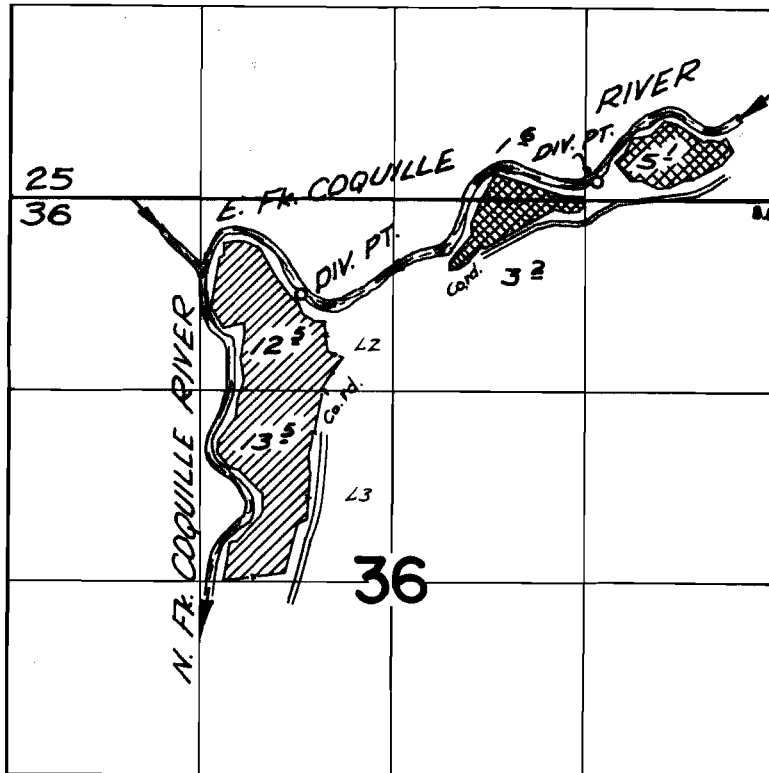

*Div. Pts. located 660 ft. S. & 3270 ft. W.; 130 ft. N. & 1240 ft. W. both from the North east corner of Section 36*

**FINAL PROOF SURVEY**  
UNDER

33570                      26560   
Application No. ~~40239~~ Permit No. ~~30048~~   
IN NAME OF

*JOHNNY JAMES KNIGHT*

Surveyed *Oct. 8, 1966*, by *V. GARNER*