


T.26S.R.12W.W.M.

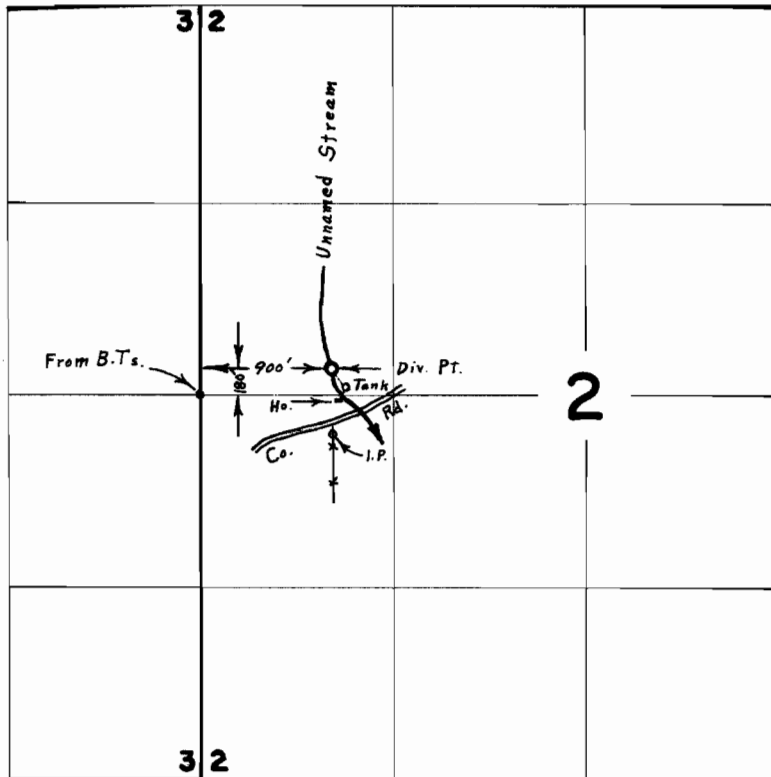

FINAL PROOF SURVEY UNDER

Application No. 41731 Permit No. 31043
IN NAME OF

DEWEY LOGUE

Surveyed Oct. 5 1966, by L. E. Gould