


# T.25S.R.12W.W.M.

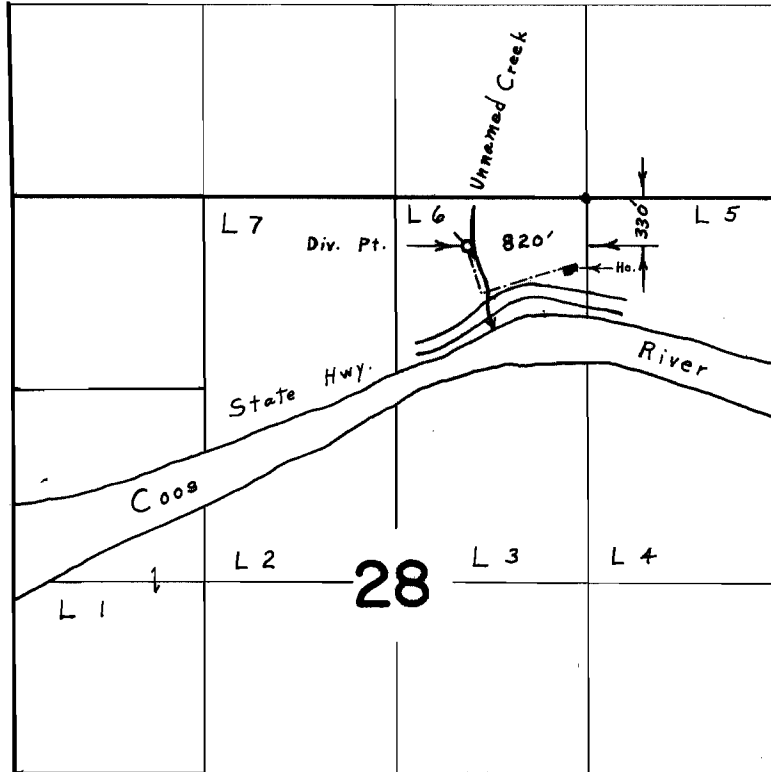

## FINAL PROOF SURVEY UNDER

Application No. 37229 Permit No. 27746  
IN NAME OF

**RONALD & SANDRA ROSE**

Surveyed Oct. 4 1966, by L. E. Gould