


# T.24S.R.13W.W.M.

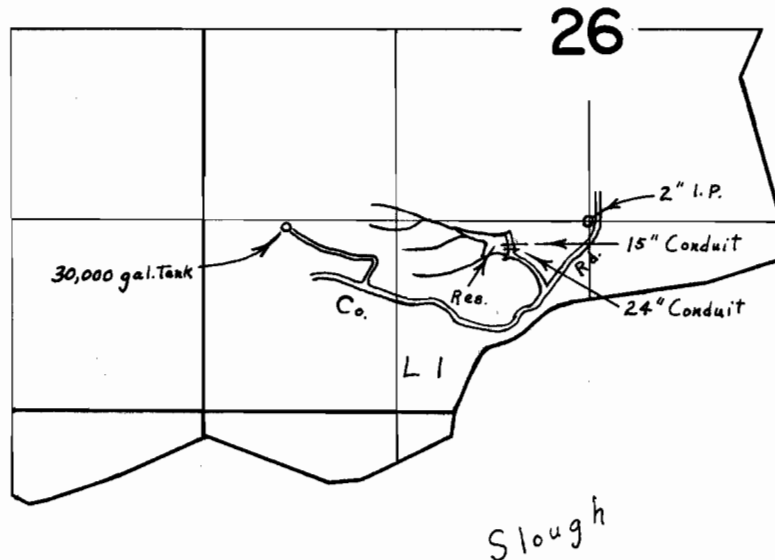

35

Div. Pt. Located 160' S. & 530' W. From the N.E. Cor., S.E.  $\frac{1}{4}$ , S.W.  $\frac{1}{4}$ , S.26

## FINAL PROOF SURVEY UNDER

Application No. R-29104. Permit No. R-1632.  
IN NAME OF

SHOREWOOD WATER CORP.

Surveyed Sept. 20, 1966., by L. E. Gould.