


T.27S. R.5W. W.M.

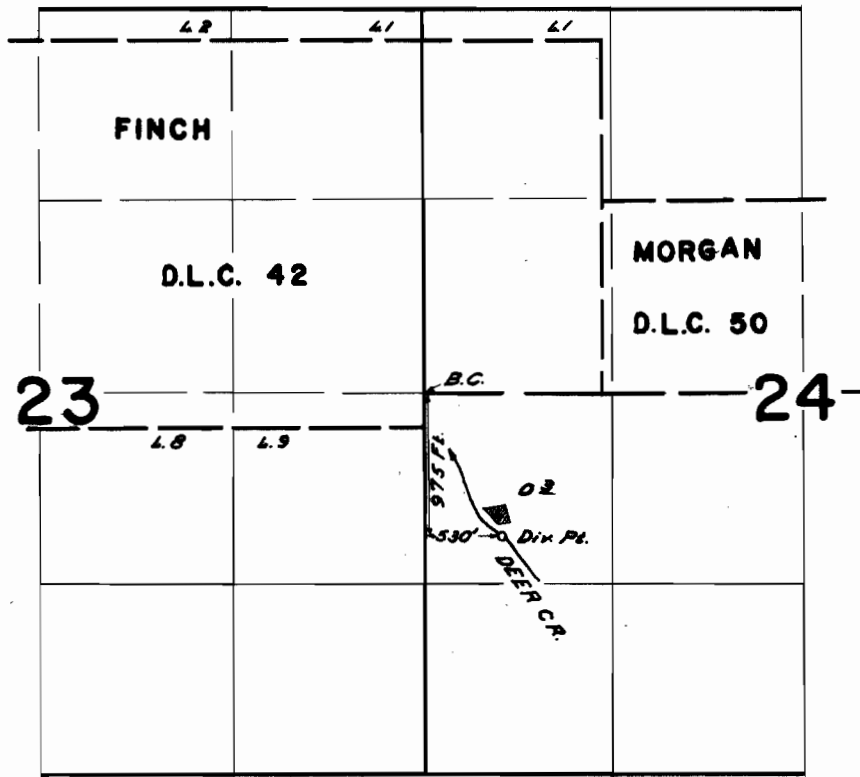

FINAL PROOF SURVEY
UNDER

Application No. 40183 Permit No. 29982
IN NAME OF

LOUIS H. BELL

Surveyed AUG. 11 1965, by L. COLEBANK