


T. 26 S. R. 3 W. W.M.

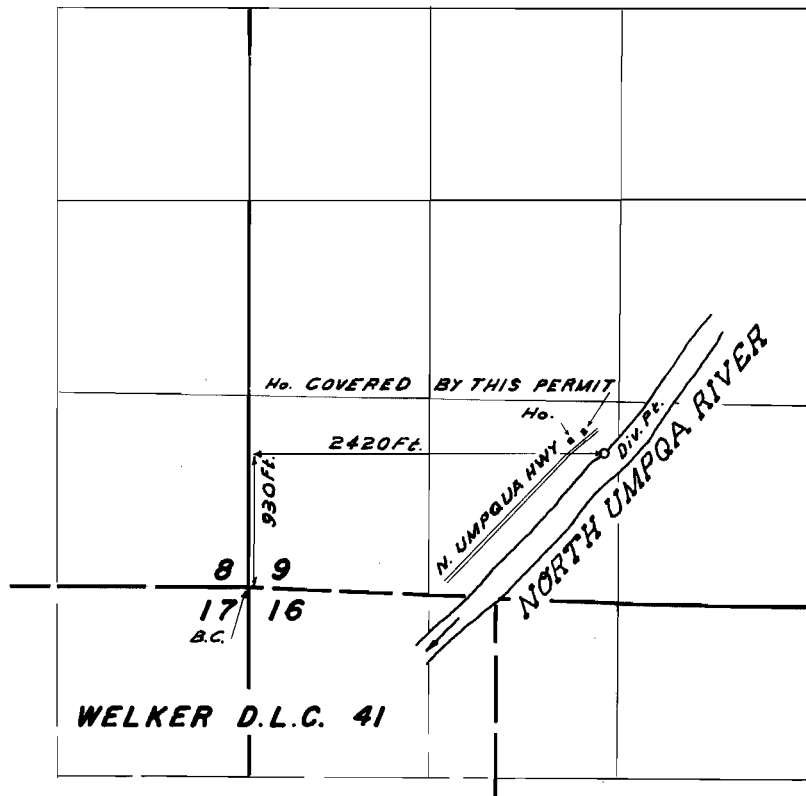

FINAL PROOF SURVEY
UNDER

Application No. 40121 Permit No. 29910
IN NAME OF

DELOS MATHEWS, BETTY JO JONES, &
MARILYN PALMER

Surveyed OCT. 26 1965, by L. COLEBANK