


T. 25 S. R. 4 W. W. M.

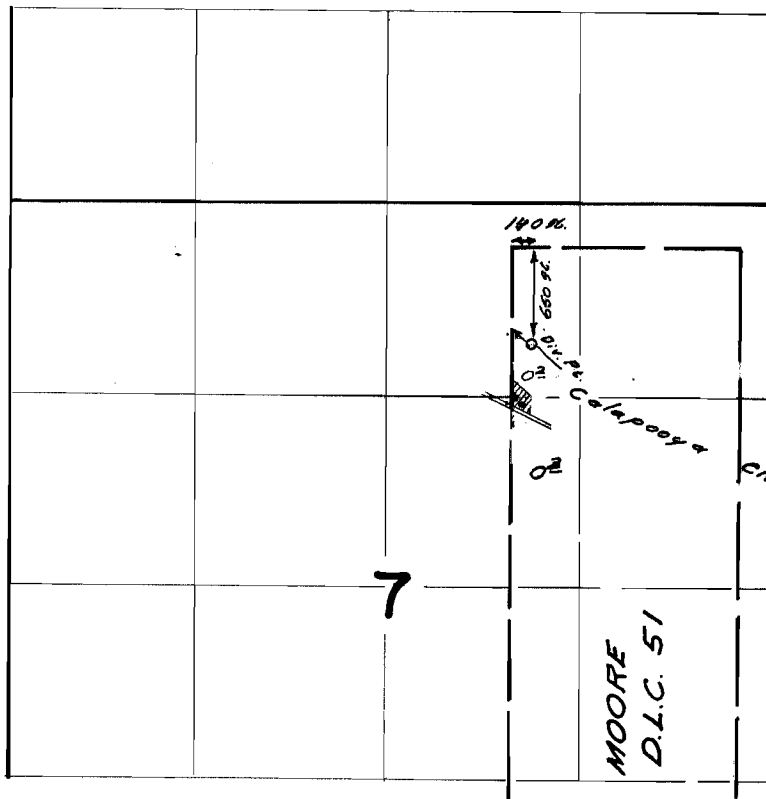

**FINAL PROOF SURVEY**  
UNDER

Application No. 39279 Permit No. 29254  
IN NAME OF

Albert Monett

Surveyed June 8 1965, by W. Ruppert