


T.27S. R.5.W.W.M.

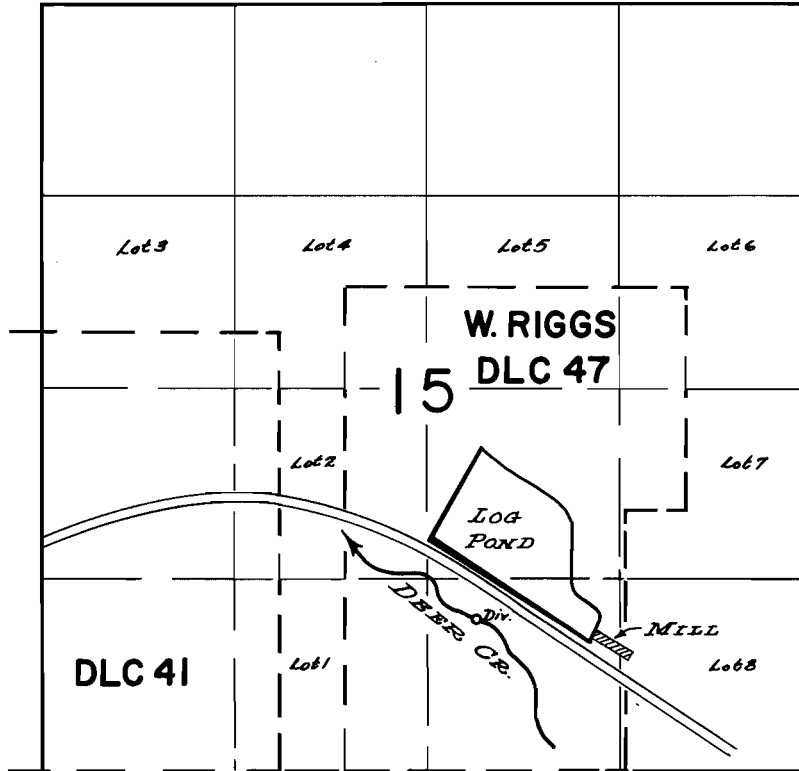

**FINAL PROOF SURVEY**  
UNDER

R-30440                      R-2212  
Application No. 30441    Permit No. 25922  
IN NAME OF

**Nordic Veneer**

Surveyed May 20, 1963, by T. Lauer