


P. 28478
33822

T.10S.R.31E.W.M.

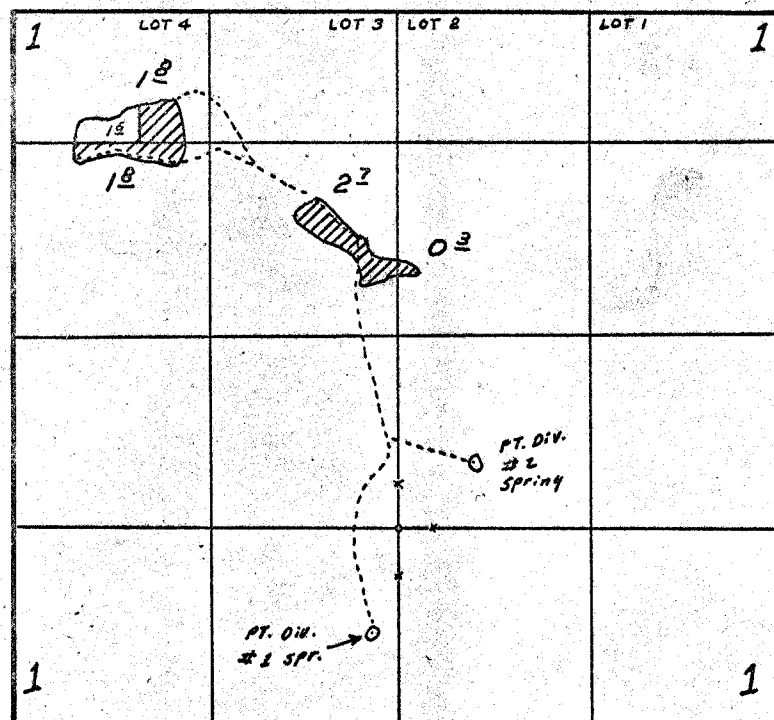

NOTE: GROUND MAP & ASSESSOR'S MAP
ADJUDICATION MAP INDICATE
THAT THIS IS A FULL
ROW OF 40'S.

FINAL PROOF SURVEY UNDER

Application No. 38221 Permit No. 28478
IN NAME OF

W. R. York

Surveyed July 15, 1964, by G. Ward

4-1964-B