


T. 26 S. R. 31 E. W. M.
SOUTH OF MALHEUR LAKE

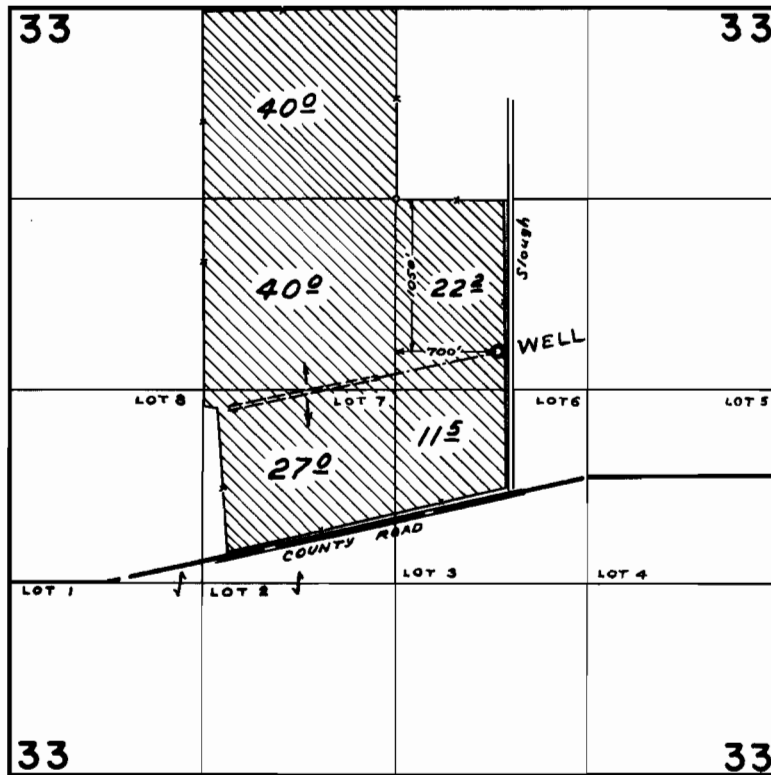

FINAL PROOF SURVEY
UNDER

Application No. G-2459 Permit No. G-2274
IN NAME OF

L. E. & R. Campbell

Surveyed SEP. 17 1965, by C. GARDNER