FINAL PROOF SURVEY

UNDER

APPLICATION NO. 31995 R-31994 PERMIT NO. 25464 R-2124

IN NAME OF

U.S. DEPT. OF INTERIOR
FISH & WILDLIFE SERVICE

SURVEYED SEPT. 17,18,&19, 1963
BY T. LAUER
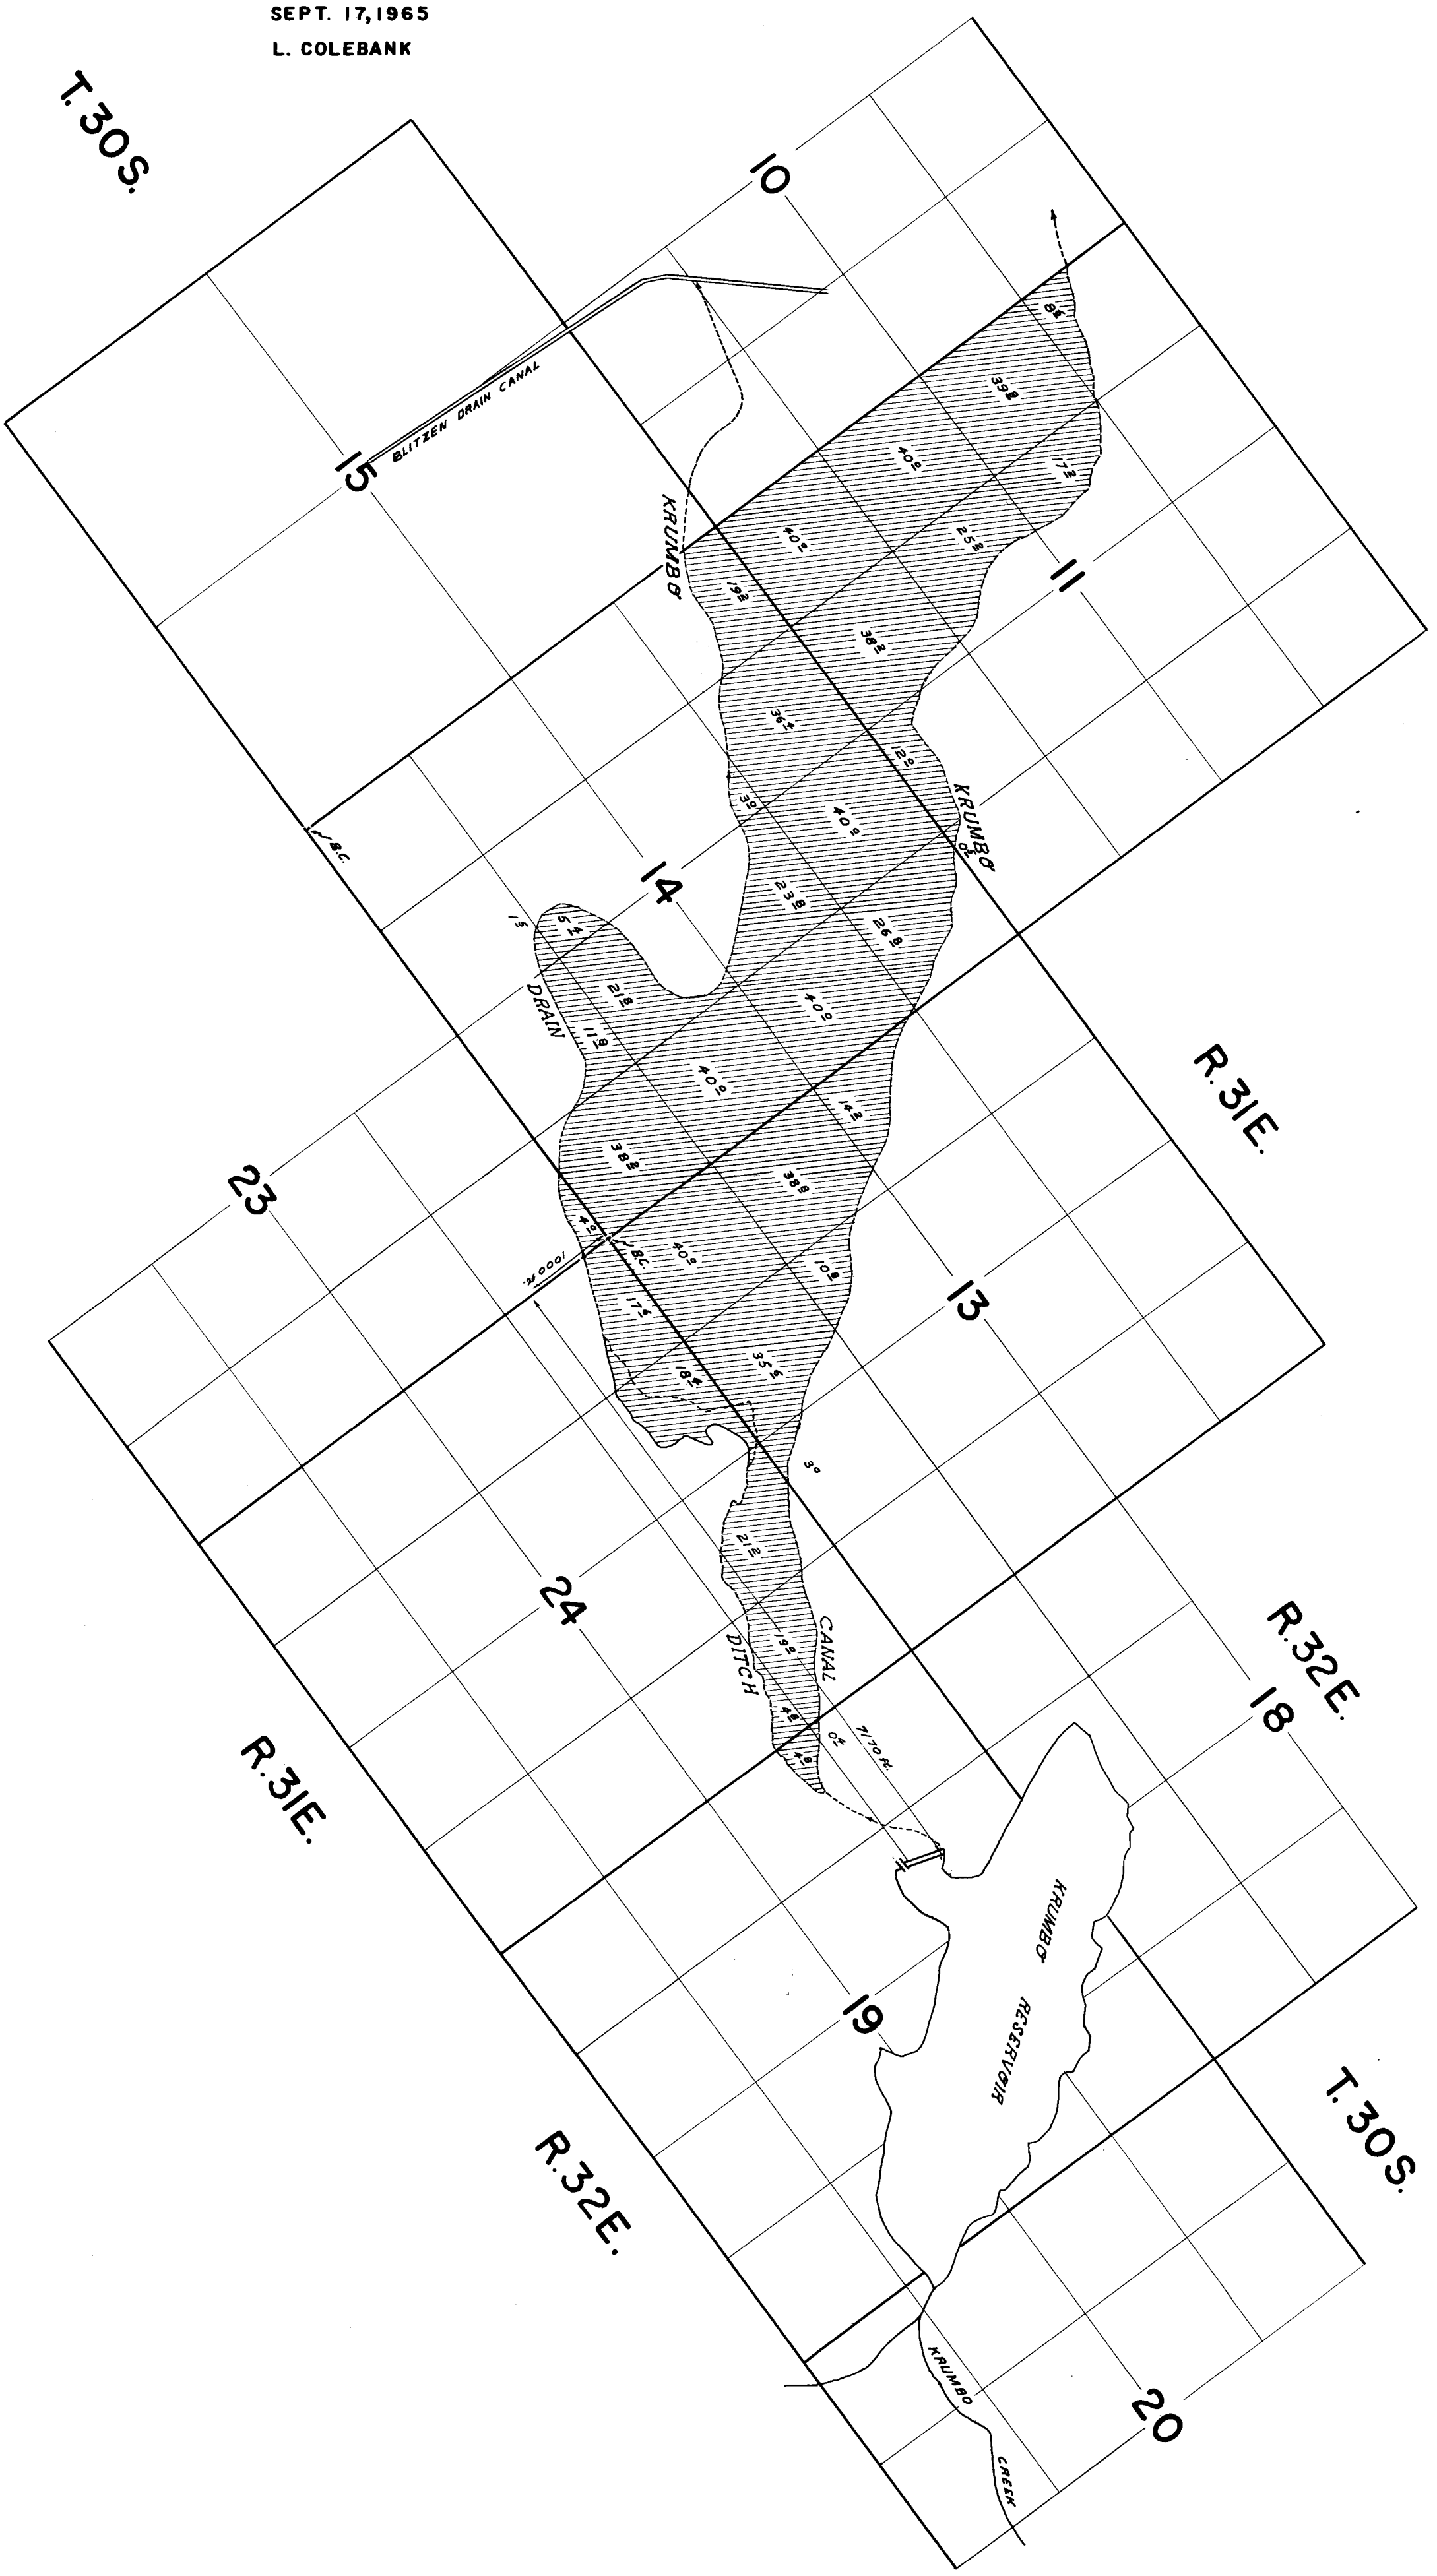
SEPT. 17, 1965
L. COLEBANK