


T.33S.R.1E.W.M.

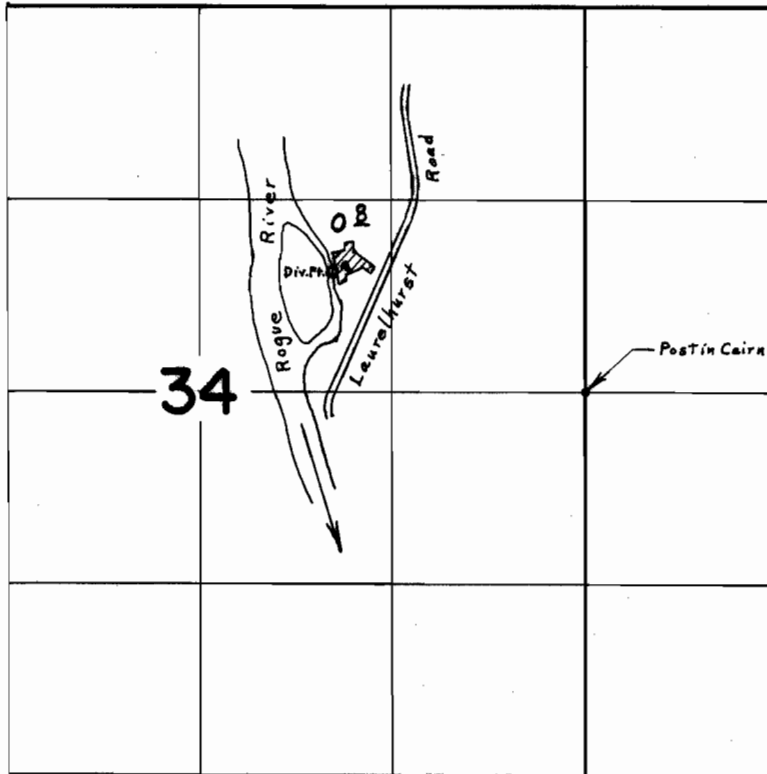

Div. Pt. Located 1730' W. & 830' N. From E.  $\frac{1}{4}$  Corner Section 34

**FINAL PROOF SURVEY**  
UNDER

Application No. 39638 Permit No. 29520  
IN NAME OF

DELOSS H. AND LUCILE L. BARBER.

Surveyed July 20 1966, by L. E. Gould