


T.33S.R.1E.W.M.

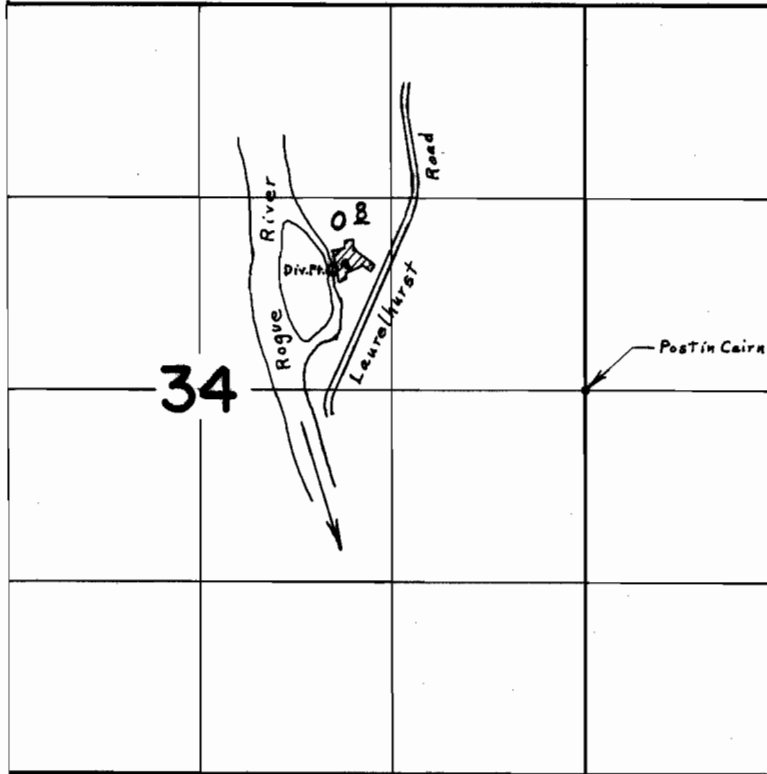

Div. Pt. Located 1730' W. & 830' N. From E. $\frac{1}{4}$ Corner Section 34


FINAL PROOF SURVEY
UNDER

Application No. 39638 Permit No. 29520
IN NAME OF

DELOSS H. AND LUCILE L. BARBER.

Surveyed July 20 1966, by L. E. Gould

T.33S.R.1E.W.M.

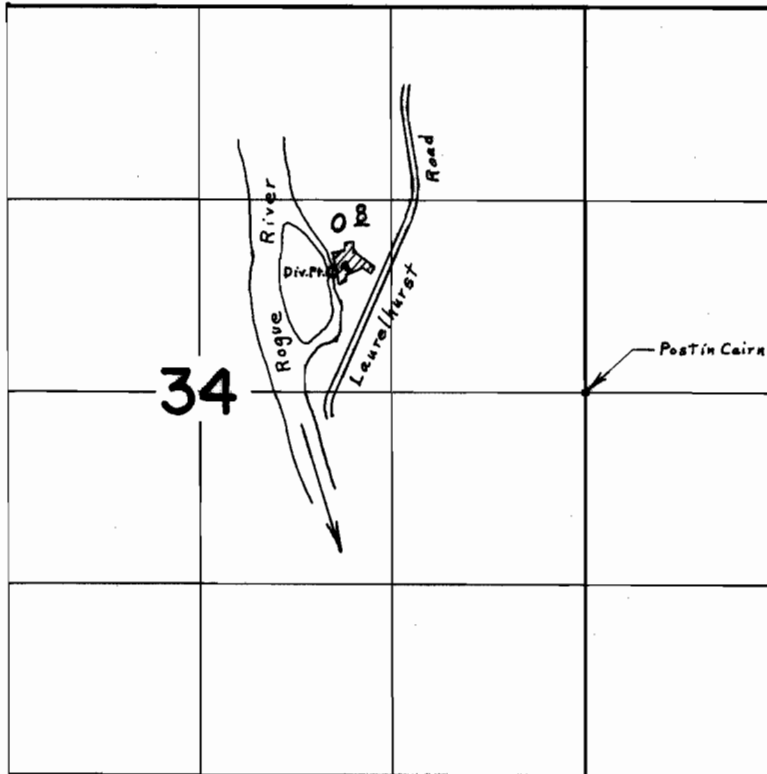

Div. Pt. Located 1730' W. & 830' N. From E. $\frac{1}{4}$ Corner Section 34

FINAL PROOF SURVEY
UNDER

Application No. 39638 Permit No. 29520
IN NAME OF

DELOSS H. AND LUCILE L. BARBER.

Surveyed July 20 1966, by L. E. Gould