


T.37S.R.4W.W.M.

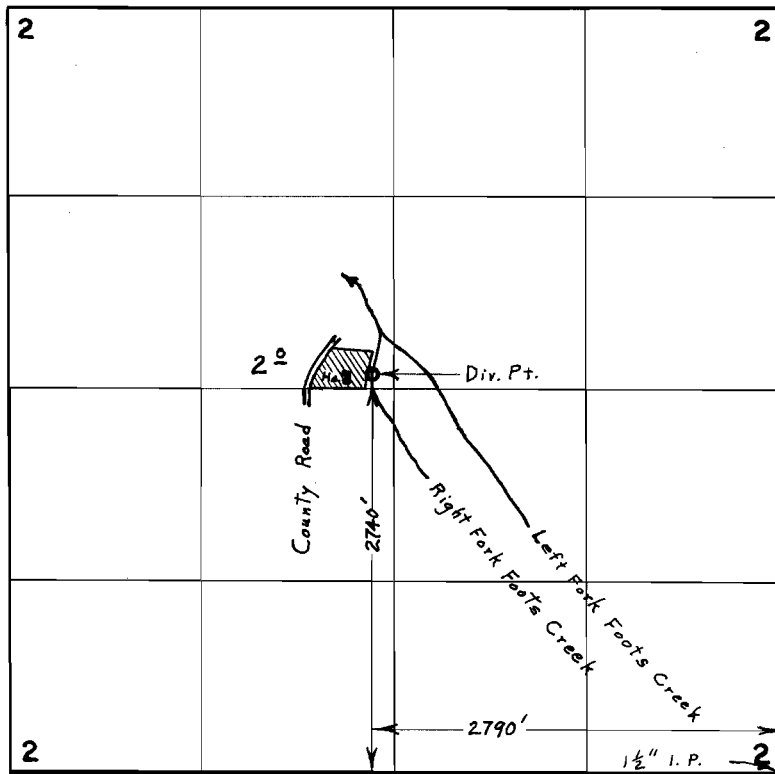

FINAL PROOF SURVEY
UNDER

Application No. 32855 Permit No. 25953
IN NAME OF

MR. & MRS. TOM BURTON

Surveyed June 7, 1966, by L. E. Gould