


T. 33 & 34 S. R. 1 W. W. M.

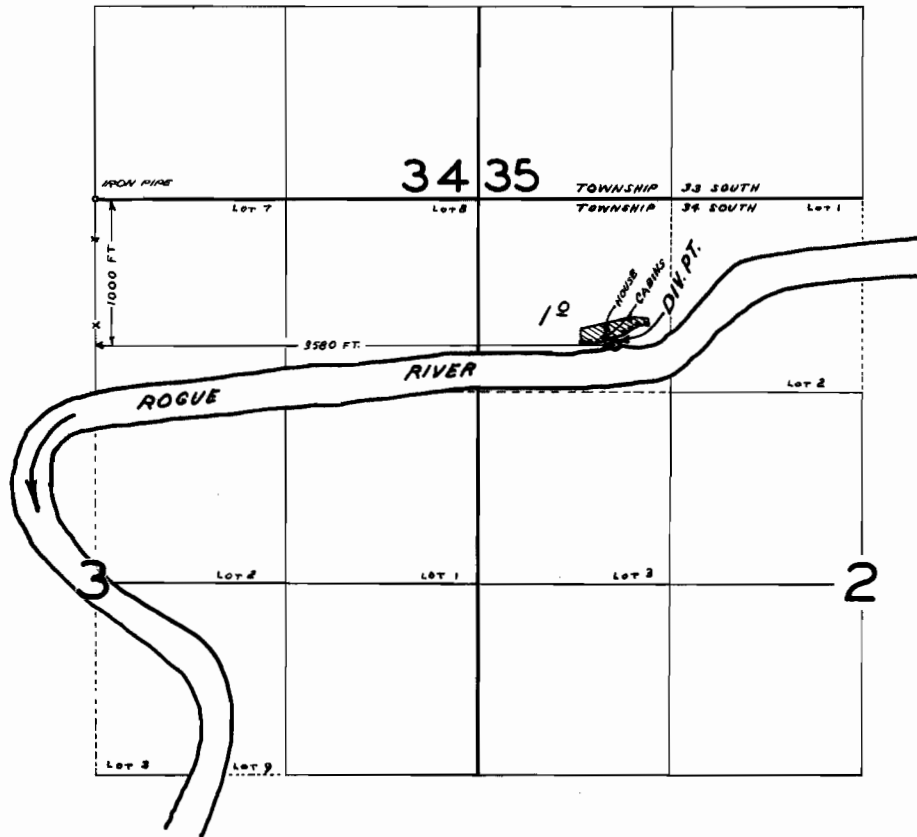

FINAL PROOF SURVEY
UNDER

Application No. 37195 Permit No. 27721

IN NAME OF

CALIFORNIA ON THE ROGUE

Surveyed JUL 9 1963 by C. BAKER
JUL 22 1965 R. JACKSON