


T. 35 S. R. 4 W. W.M.

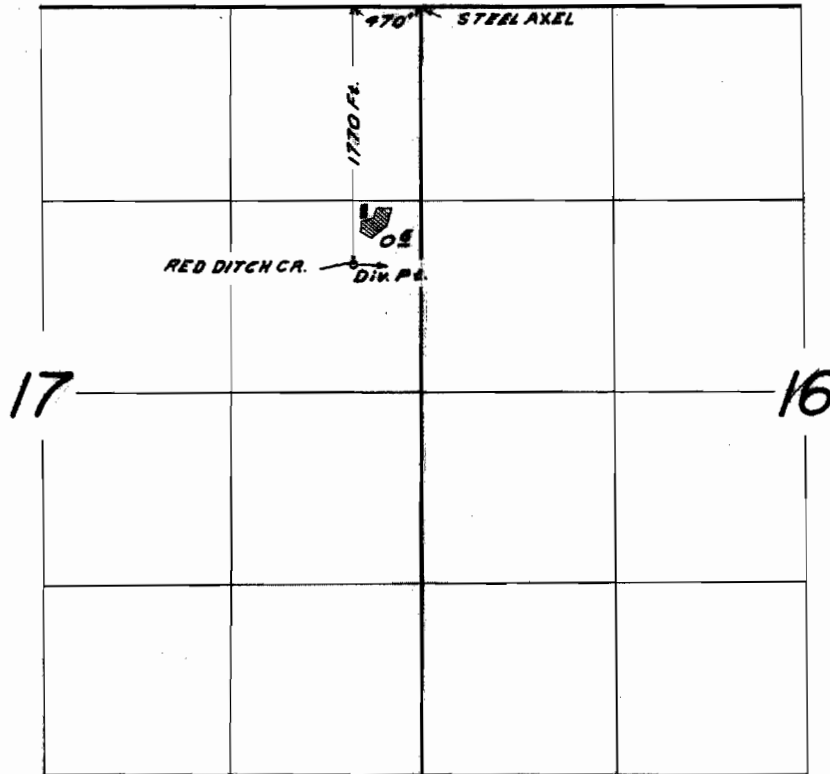

FINAL PROOF SURVEY
UNDER

Application No. 34348 Permit No. 27008
IN NAME OF

PAUL & KATHERINE McBRIDE

Surveyed JUNE 29 1963 by L. COLEBANK