


T.33S.R.1W.W.M.

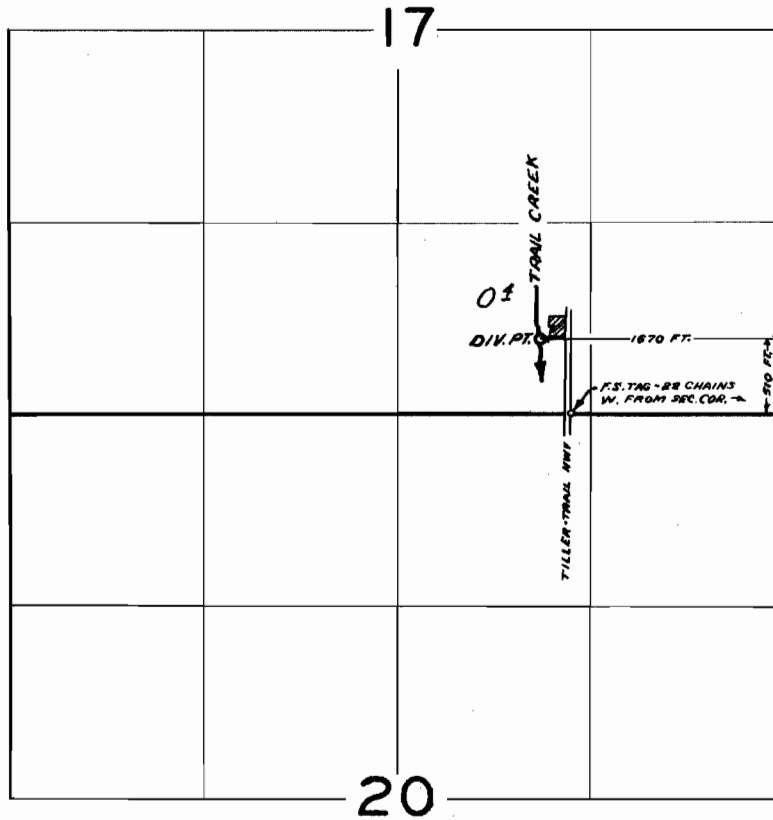

**FINAL PROOF SURVEY**  
UNDER

Application No. 39019 Permit No. 29064

IN NAME OF

JOHN E. SIMPSON

Surveyed Jul. 15 1965, by C. GARDNER