


T. 36.S. R. 10E. W. M.

Sprague River

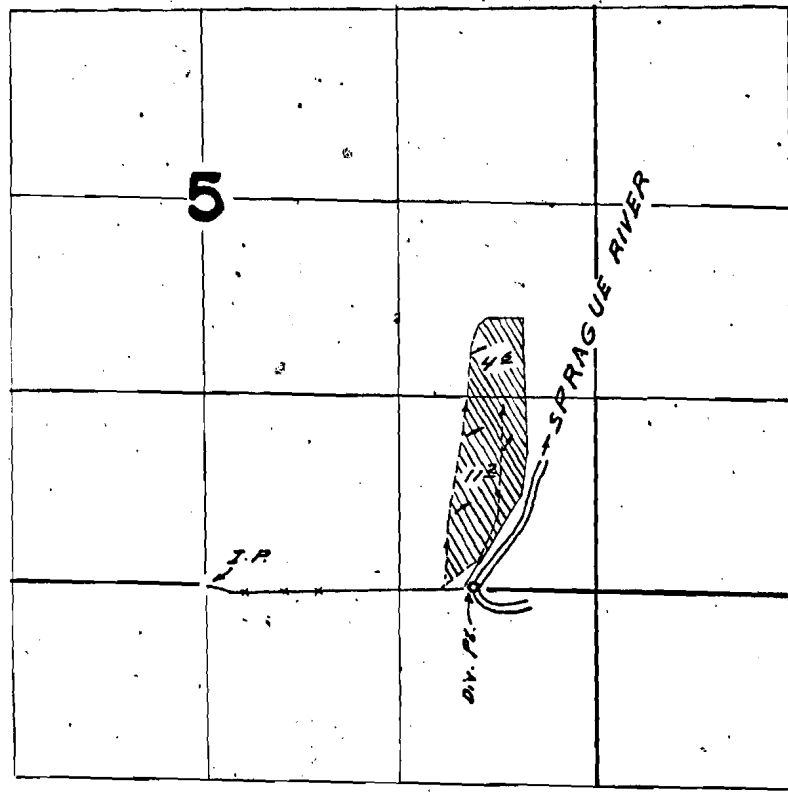

Div. Pl. 2016. N. & 1790 N. E. from 3 1/4 Cor. Sec. 5.

FINAL PROOF SURVEY UNDER

Application No. 33699 Permit No. 26736
IN NAME OF

Anna Z. & Emmett J. Lakoda, Sr.

Surveyed Sept. 9, 1966, by W. J. Ruppert.