


# T. 16 S. R. 4 W. W.M.

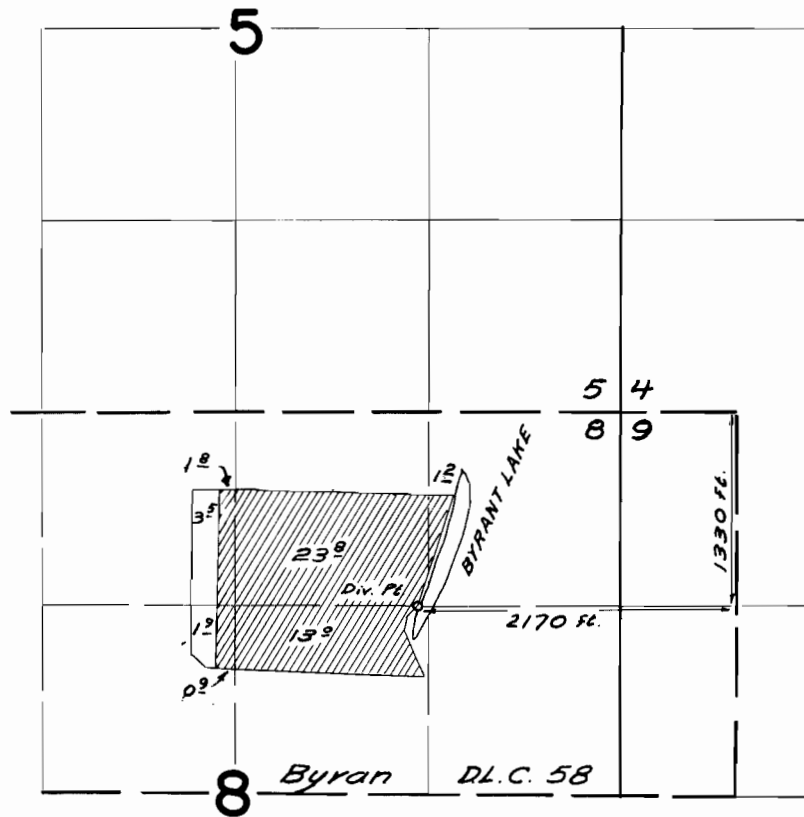

## FINAL PROOF SURVEY UNDER

Application No. 37307 Permit No. 27793  
IN NAME OF

Eleanor June Hughs

Surveyed May 18 1966, by WJ Ruppert