


T.16S. R.5W. W.M.

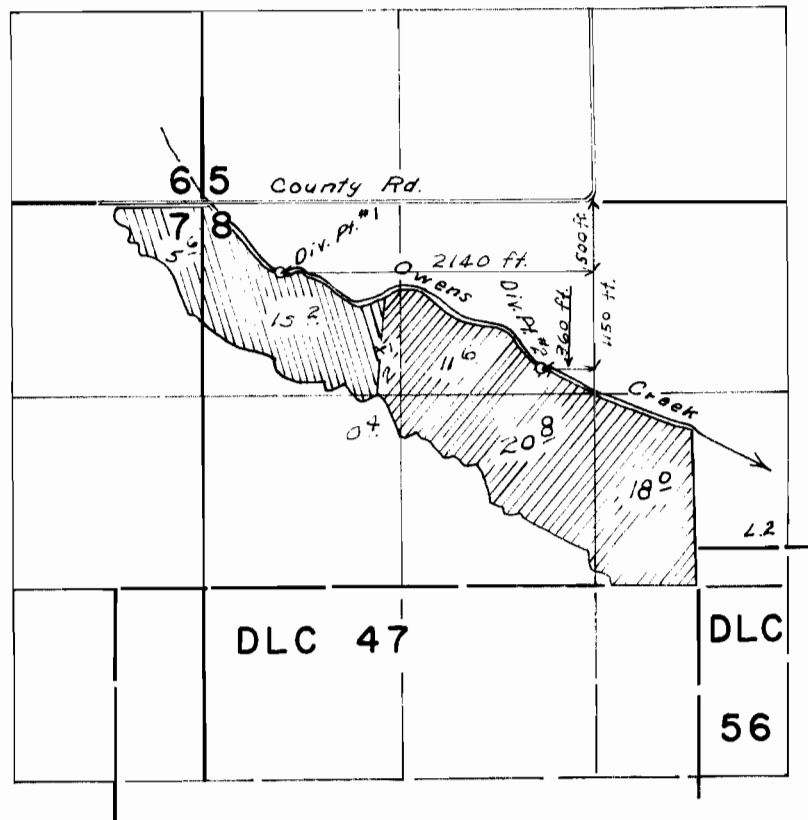

FINAL PROOF SURVEY
UNDER

Application No. 38852 Permit No. 28899...
IN NAME OF
ERNEST B. SMYTH

Surveyed May 6, 1965, by *Clayton L. Gardner*