


T.18S.R.5W. W.M.

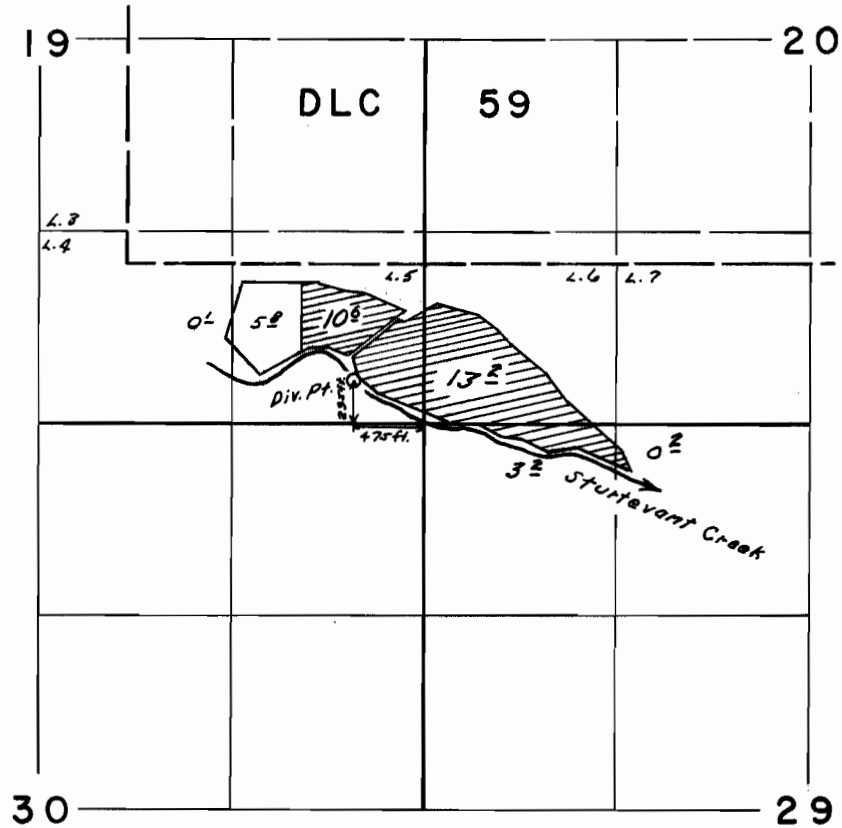

FINAL PROOF SURVEY UNDER

Application No. 33607... Permit No. 26573...
IN NAME OF

ALDEN L. & BEATRICE STURTEVANT

Surveyed April 28, 1965, by *Clayton J. Gardner*