


T.16S.R.4&5W.W.M.

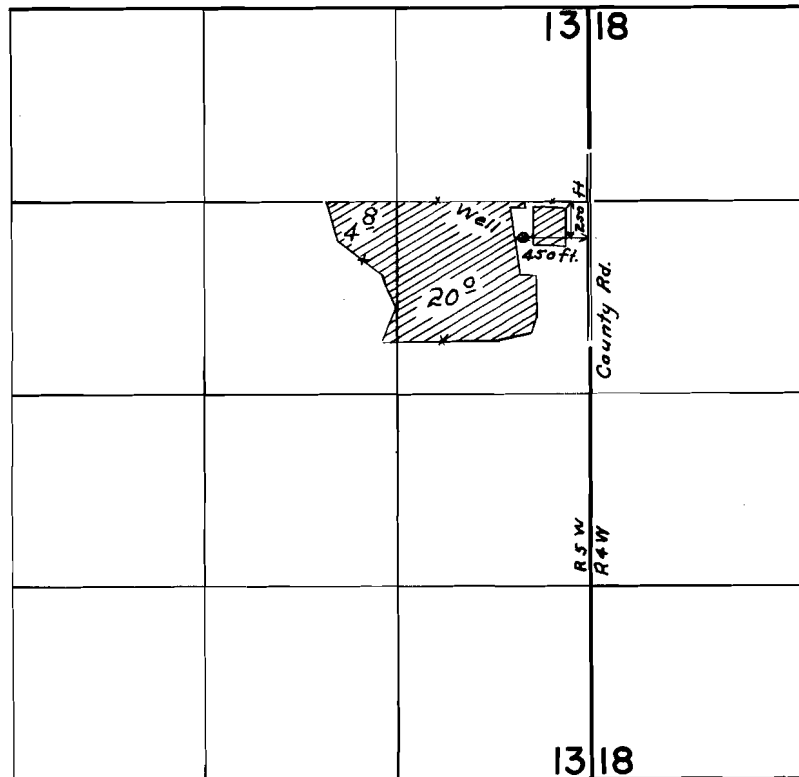

FINAL PROOF SURVEY
UNDER

Application No. G-1666 Permit No. G-1525
IN NAME OF

EDWARD H. VOGT

Surveyed May 4, 1965, by *Clayton J. Anderson*