


T.16S.R.7W.W.M.

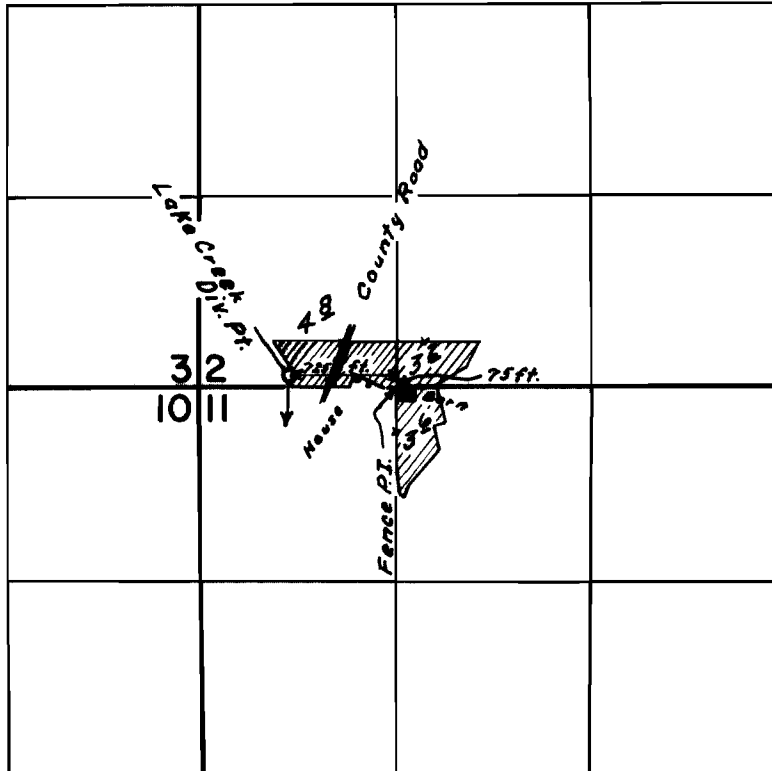

FINAL PROOF SURVEY
UNDER

Application No. 37639 Permit No. 28112
IN NAME OF
WILLIAM A. WAGNER

Surveyed April 29, 1965, by Clayton J. Gardner