


T. 13S. R. 9 & 10 W. W.M.

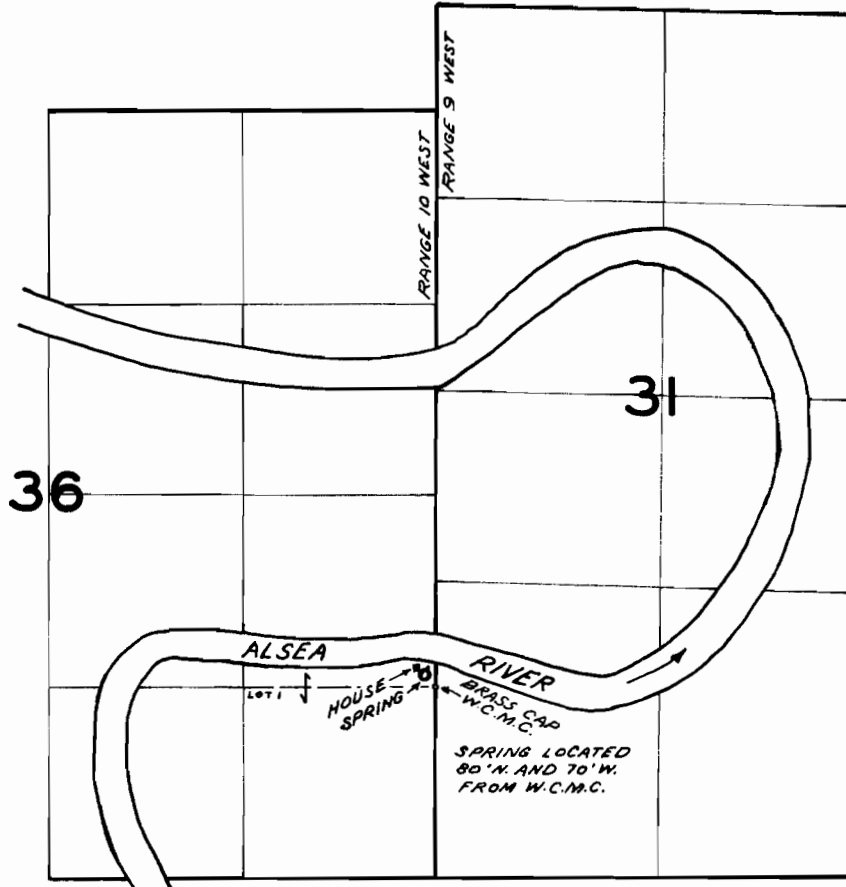

FINAL PROOF SURVEY
UNDER

Application No. 38505 Permit No. 28669

IN NAME OF

LLOYD M. SPIKER

Surveyed SEP. 23 1964, by F. SEIGMUND