


T. 12S. R. 1W. W.M.

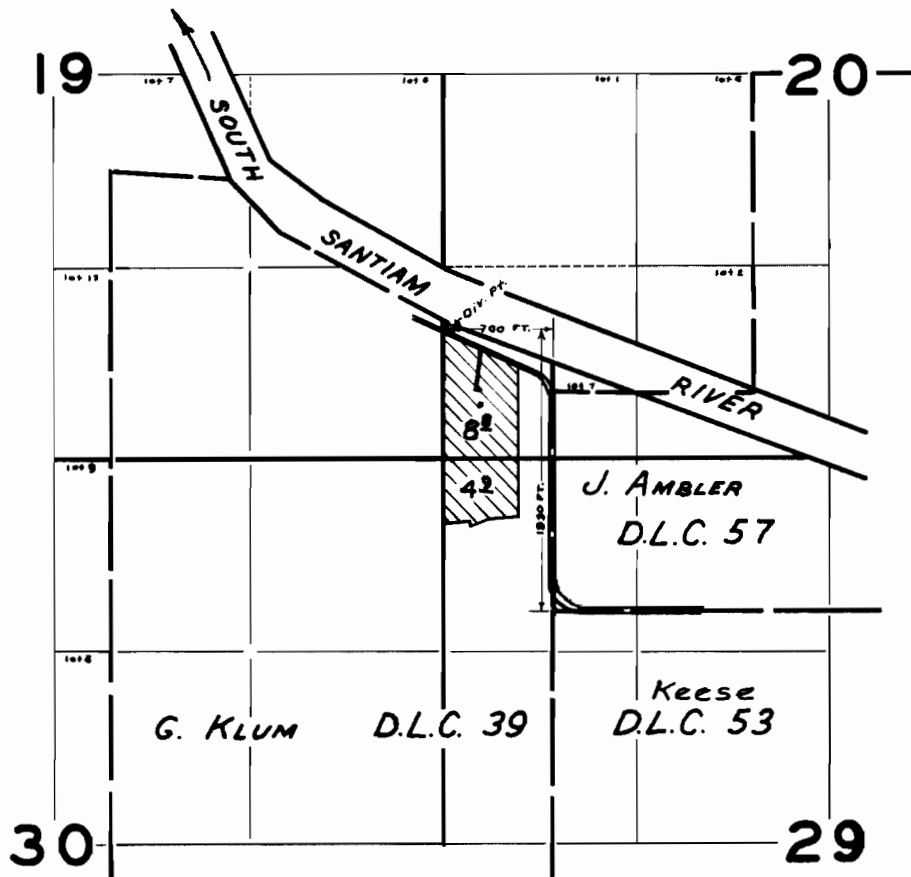

FINAL PROOF SURVEY
UNDER

Application No. 38078 Permit No. 28391

IN NAME OF

D. R. CHILDS

Surveyed SEP. 20, 1965, by R. JACKSON