


T.11&12S. R.4 W. W.M.

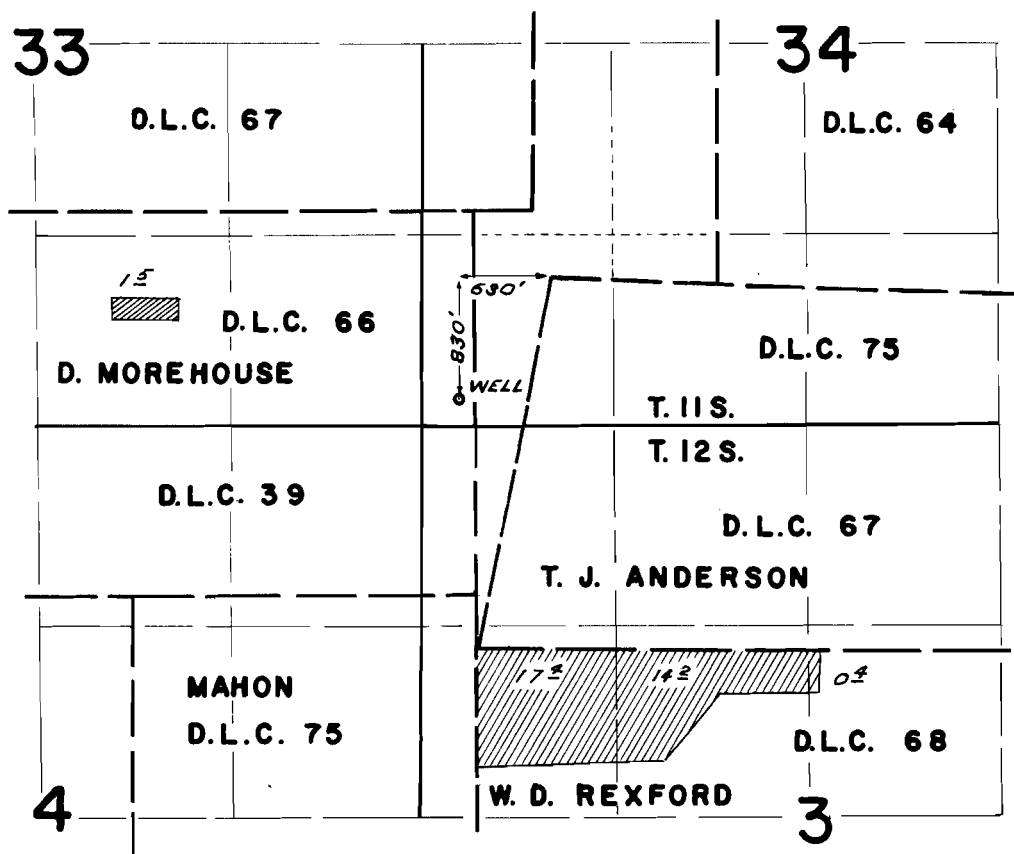

FINAL PROOF SURVEY
UNDER

Application No. G-1905 Permit No. G-1743
IN NAME OF

JOHN & LETHA GLASER

Surveyed SEPT. 25 1964, by C. GARDNER
SEPT 30, 1965 L. COLEBANK