


T.IOS. R.IW. W.M.

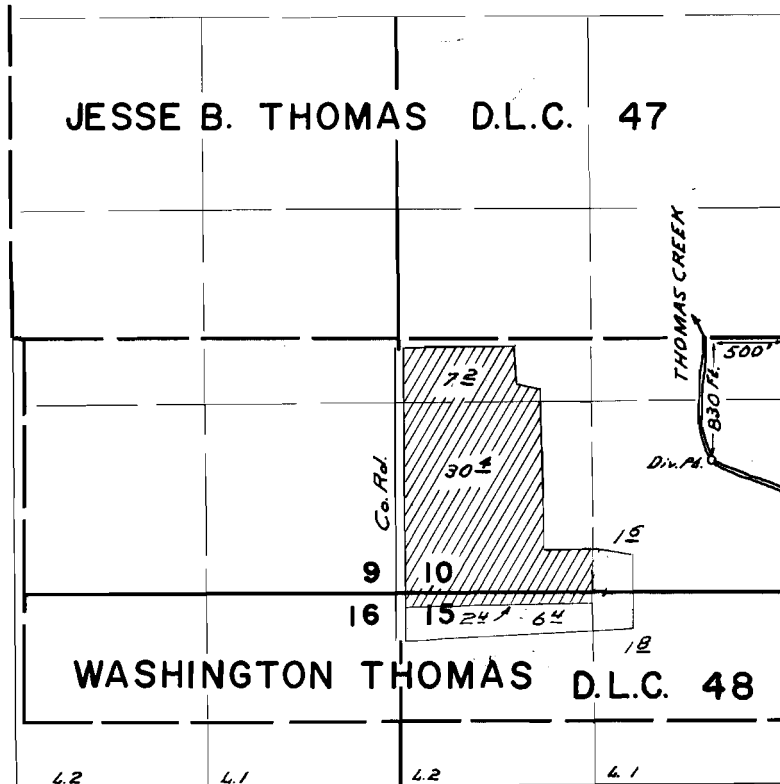

FINAL PROOF SURVEY
UNDER

Application No. 39985 Permit No. 29784
IN NAME OF

KAISER & HATCH

Surveyed SEPT. 10 1965, by L. COLEBANK