


T. 10 S. R. 3 W. W. M.

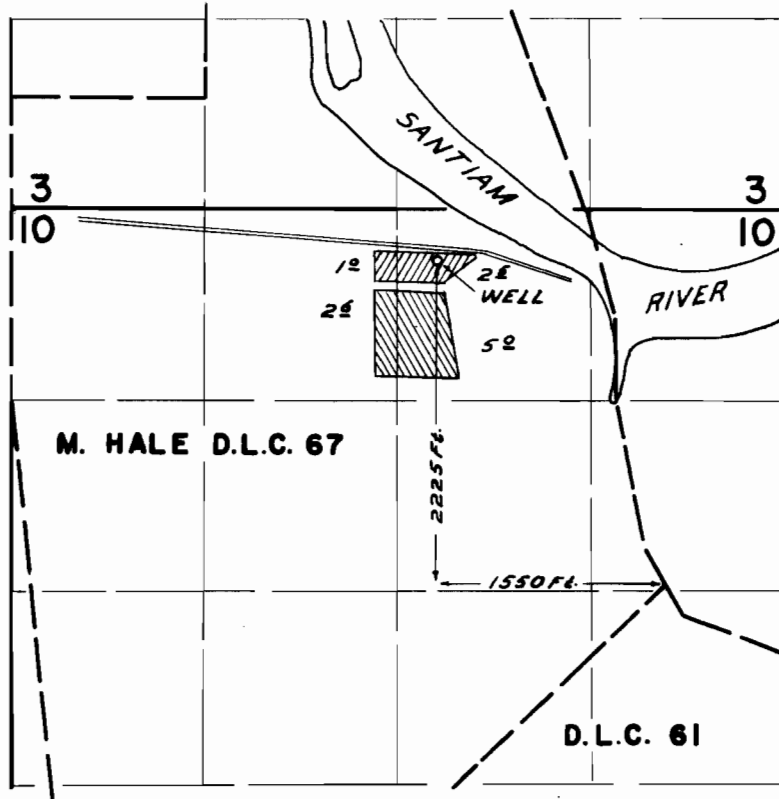

PRIMARY  SUPPLEMENTAL

FINAL PROOF SURVEY
UNDER

Application No. G-2256 Permit No. G-2073
IN NAME OF

WALTER E. & VIRGINIA M. KREGER

Surveyed SEPT. 9, 1965, by L. COLEBANK