


# T. 11 S. R. 4 W. W.M.

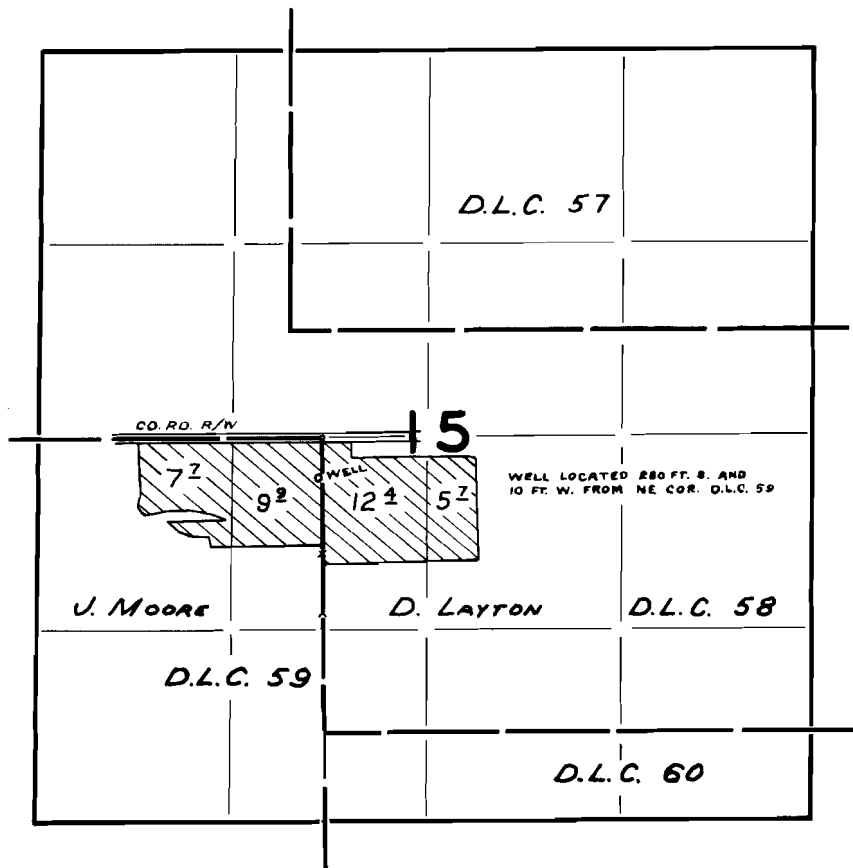

## FINAL PROOF SURVEY UNDER

Application No. C-3044 Permit No. C-2840  
IN NAME OF

W. F. & ELDRED C. STELLMACHER

Surveyed OCT. 12, 1965, by R. JACKSON