




T.13S.R.1E.W.M.

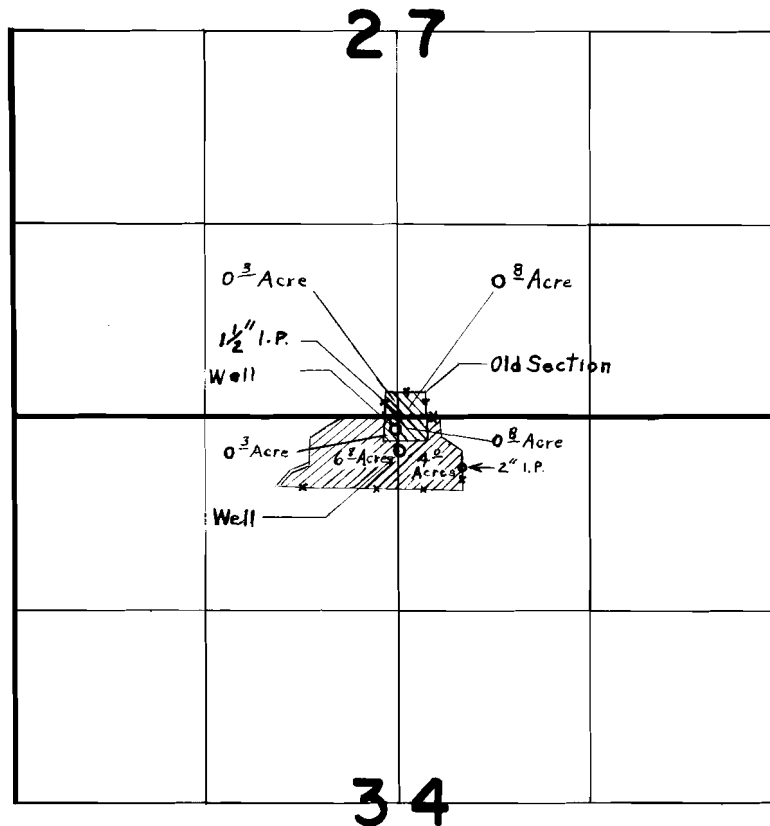

N. Well  Located 80' S. & 20' W.

S. Well  Located 230' S. & 10' E.

Both From N. 1/4 Corner Section 34

FINAL PROOF SURVEY UNDER

Application No. G-3069. Permit No. G-2860.
IN NAME OF

SWEET HOME CEMETERY MAINTENANCE DISTRICT

Surveyed April 18, 1966, by *L. E. Gould*