


T.10S. R.2W. W.M.

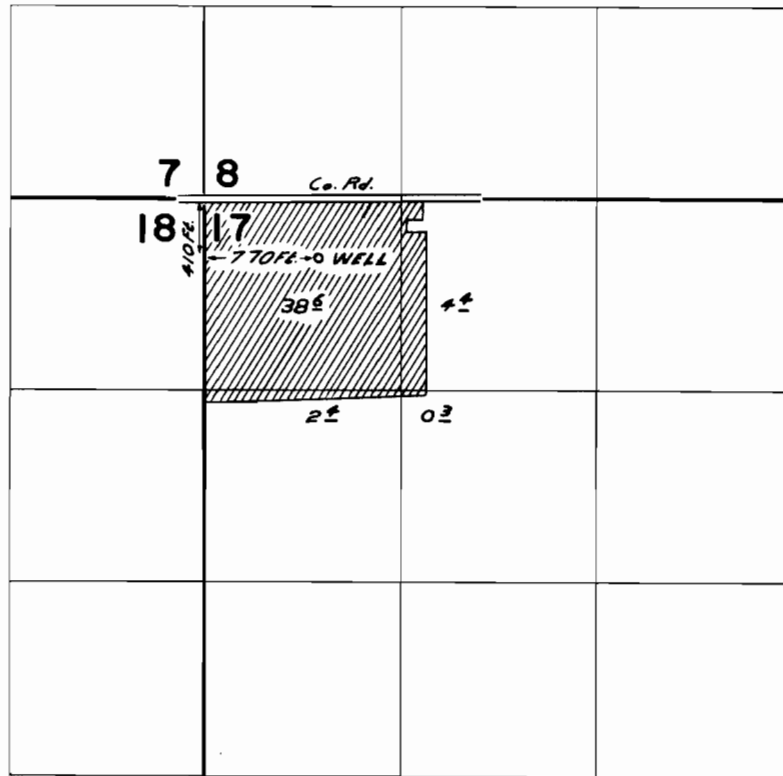

**FINAL PROOF SURVEY**  
UNDER

Application No. G-2272 Permit No. G-2804  
IN NAME OF

MRS. TESSA WATKINS

Surveyed SEPT 9, 1965, by L. COLEBANK