
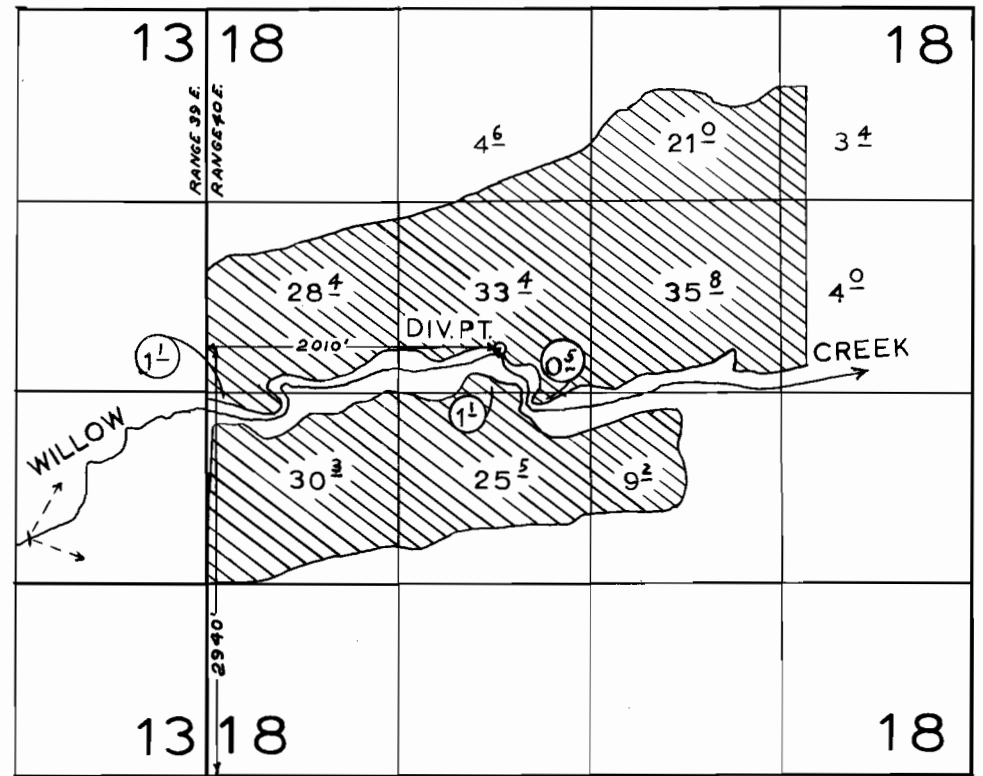


T.14S.R.39 8 40E.W.M.

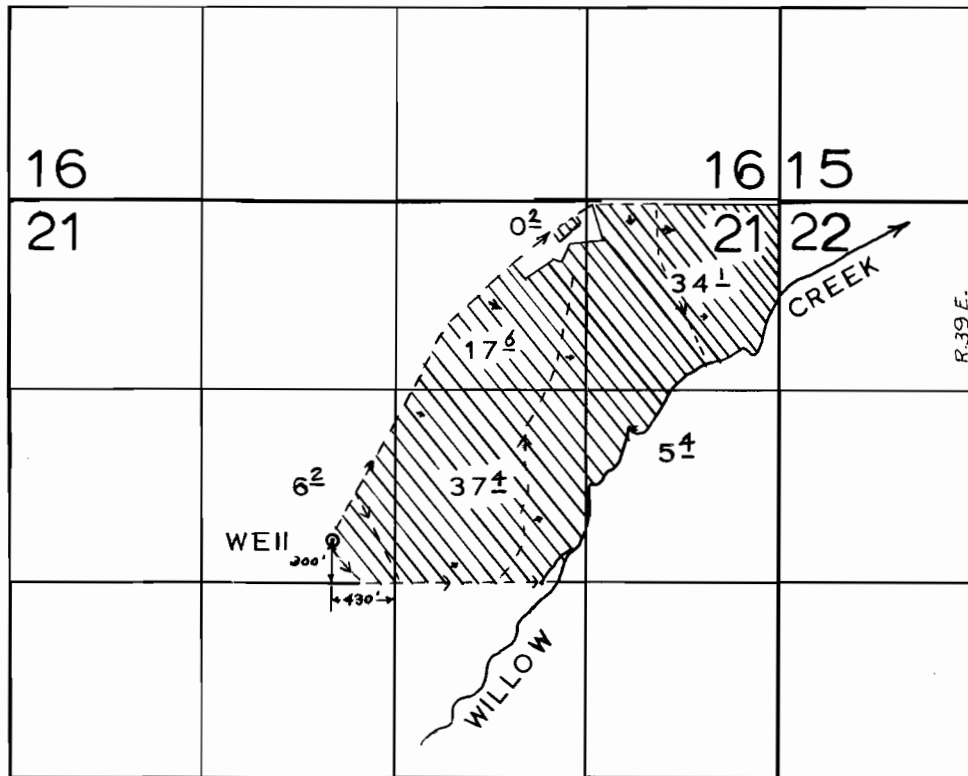

FINAL PROOF SURVEY

UNDER

TRANSFER NO. D-99

APPLICATION NO. G-2320

PERMIT NO. G- 2146

IN NAME OF

DUNCAN AND OAKES

SURVEYED NOV. 3 + 4, 1965

BY *Frank Wolfson*