


T.15S.R.47E.W.M.

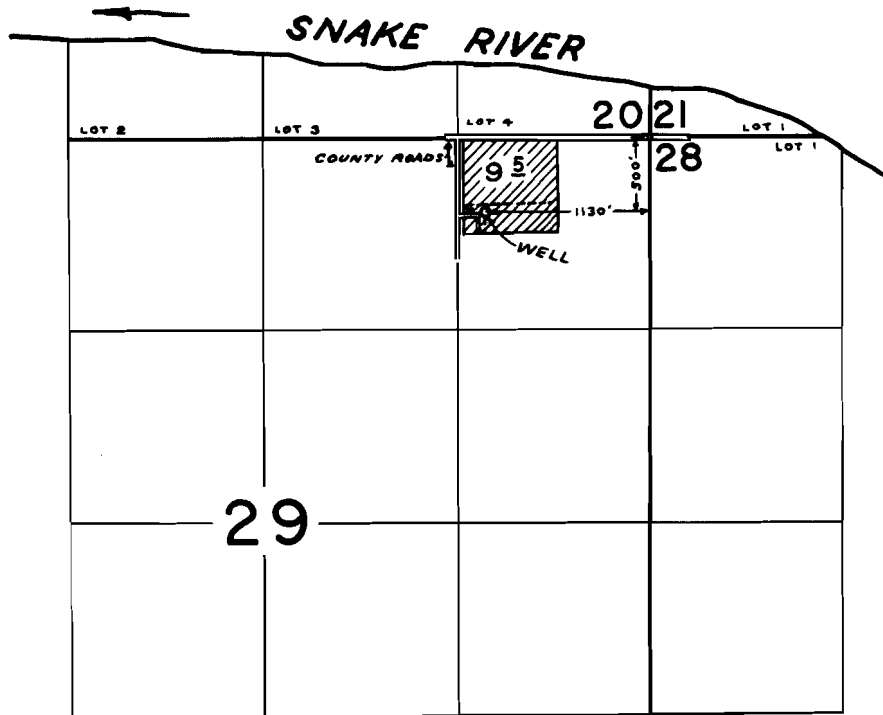

FINAL PROOF SURVEY
UNDER

Application No. G-2945 Permit No. G-2738
IN NAME OF

Pearl R. LeVander

Surveyed Oct 6 1965, by C. GARDNER