


T. 21 S. R. 46 & 47 E. W. M.

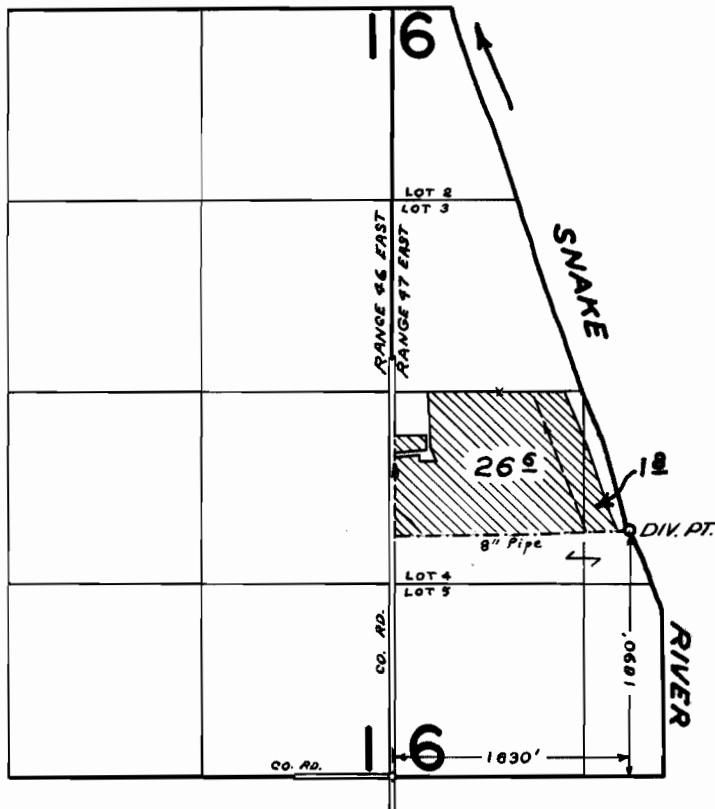

FINAL PROOF SURVEY UNDER

Application No. 37279 Permit No. 27927
IN NAME OF

D. J. Nelson

Surveyed Oct 14 1965, by C. GARDNER