


T. 18 S. R. 46 E. W. M.

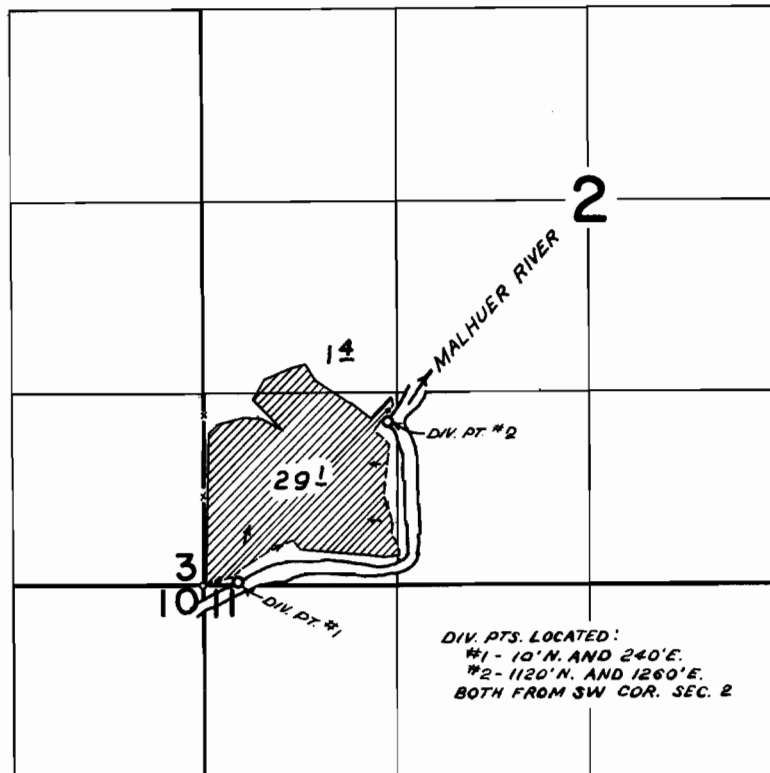

FINAL PROOF SURVEY UNDER

Application No. 40566 Permit No. 30271
IN NAME OF

Albert M. Spencer

Surveyed Oct. 14 1965, by C. GARDNER