


T. 5 S. R. 2 W. W. M.

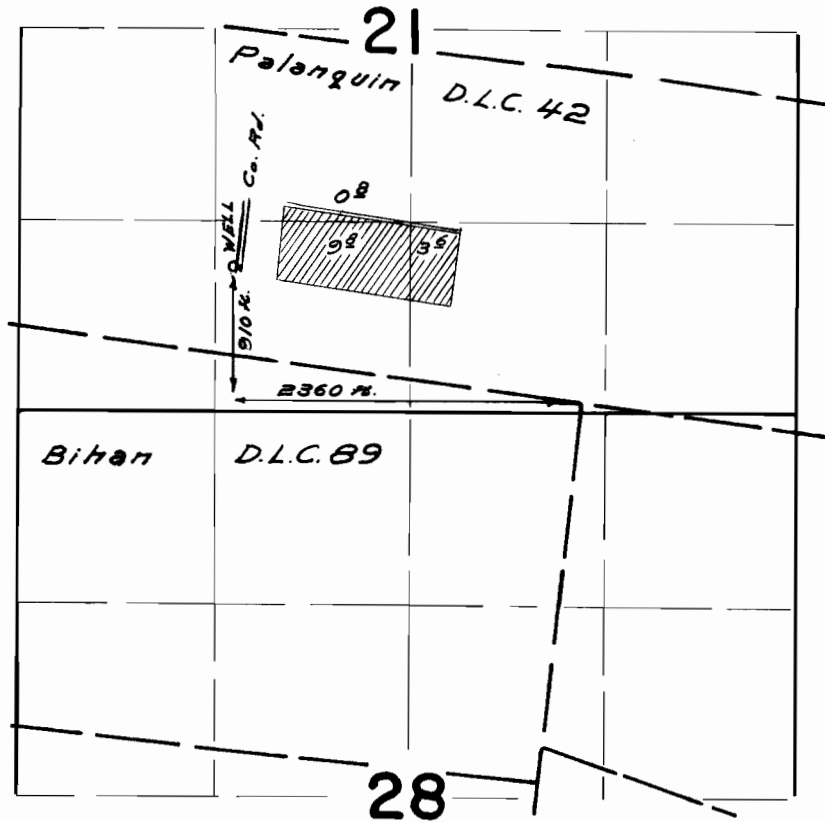

FINAL PROOF SURVEY
UNDER

Application No. G-1699 Permit No. G-1559
IN NAME OF

Bernard J. Ferschweiler

Surveyed Aug 20 1965, by C. Gardner