


# T. 10 S. R. 2 W. W.M.

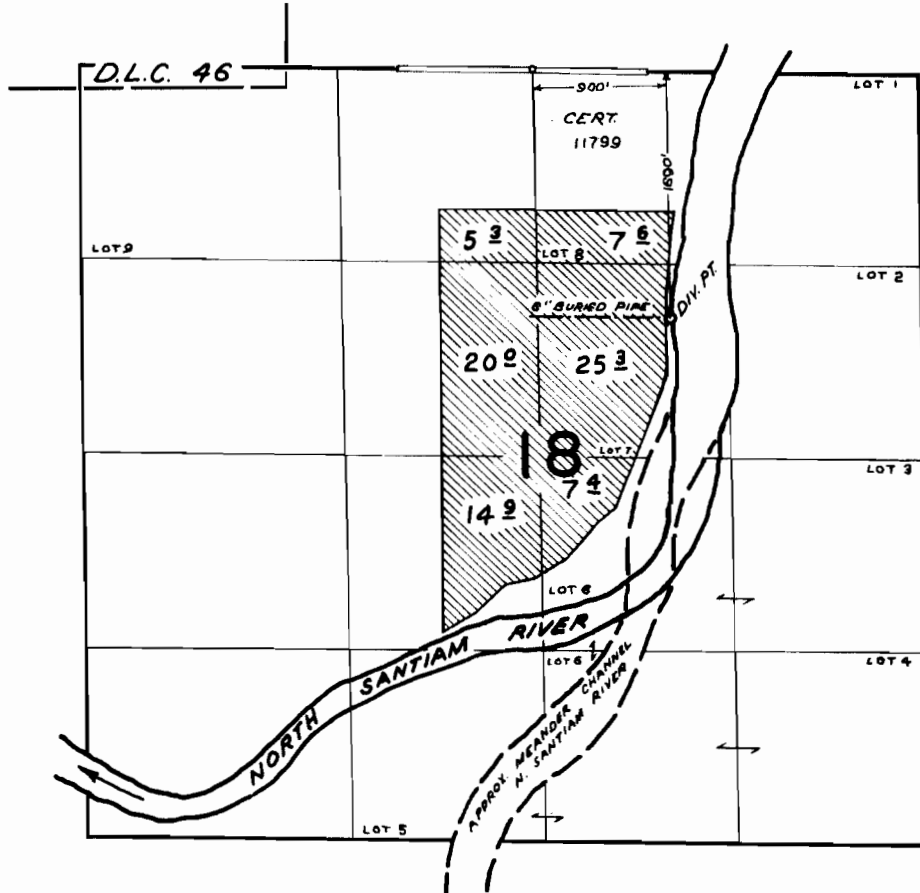

## FINAL PROOF SURVEY UNDER

Application No. 33987 Permit No. 26783

IN NAME OF

Roy Dean Tilley

Surveyed JUN. 17 1965, by C. GARDNER