


T. 1 S. R. 1 E. W. 1 M.

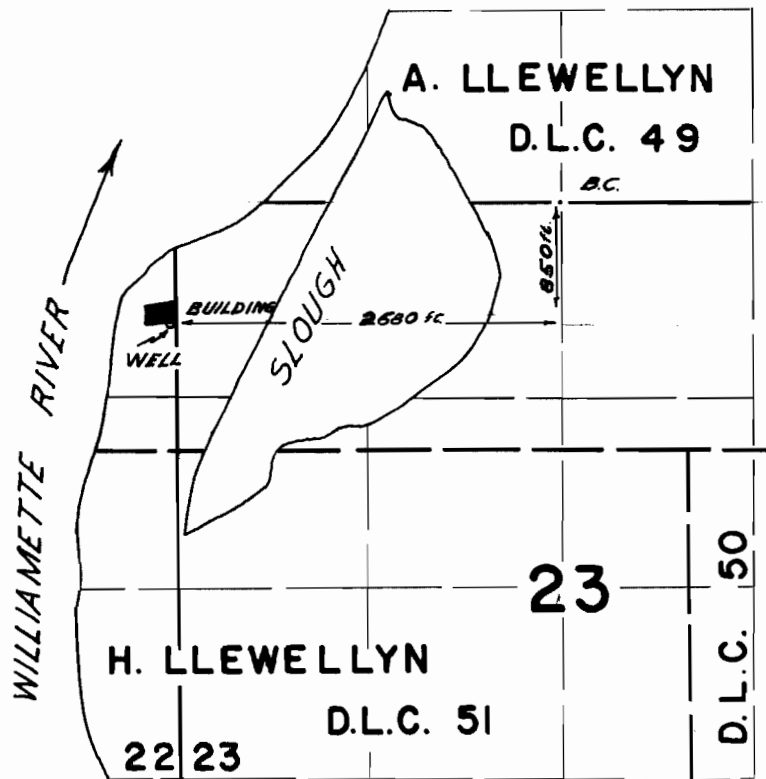

FINAL PROOF SURVEY
UNDER

Application No. 6-2426 Permit No. 6-2260
IN NAME OF

ROBERT E. BOLLINGER

Surveyed SEPT. 8 1965, by C. GARDNER