


T.1N. R.3E. W.M.

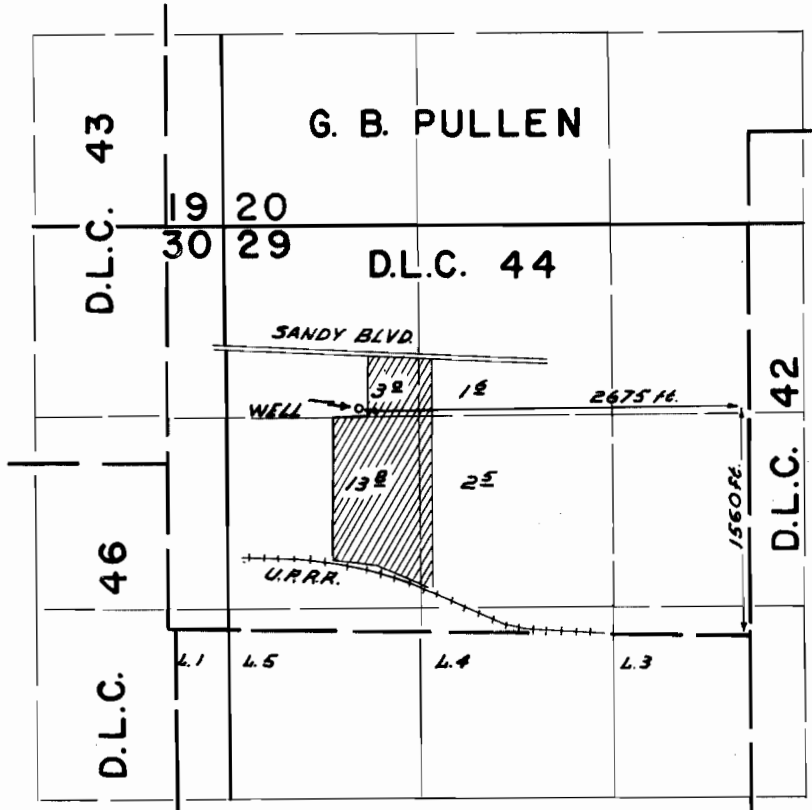

FINAL PROOF SURVEY
UNDER

Application No. G-2350 Permit No. G-2163
IN NAME OF

CEREHINO BROTHERS

Surveyed SEPT 9 1965, by C. GARDNER