


T. 9 S. R. 6 W. W. M.

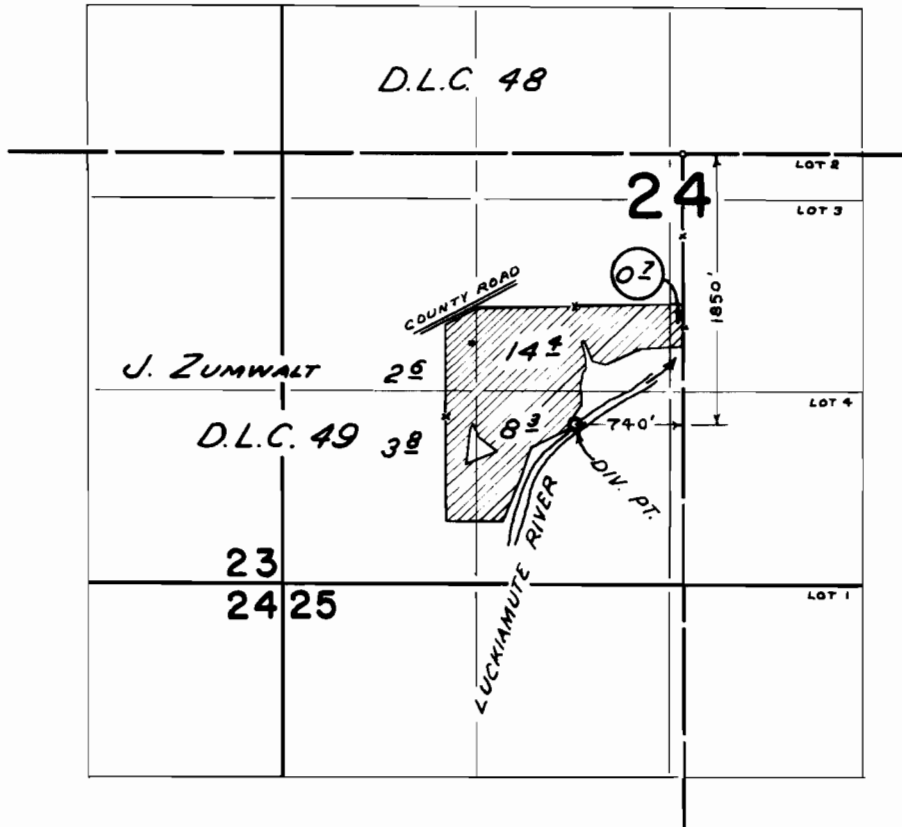

FINAL PROOF SURVEY UNDER

Application No. 34765 Permit No. 27290

IN NAME OF

Donald E. Brostrom

Surveyed Aug 6 1965, by C. GARDNER