


T.6S. R.3W. W.M

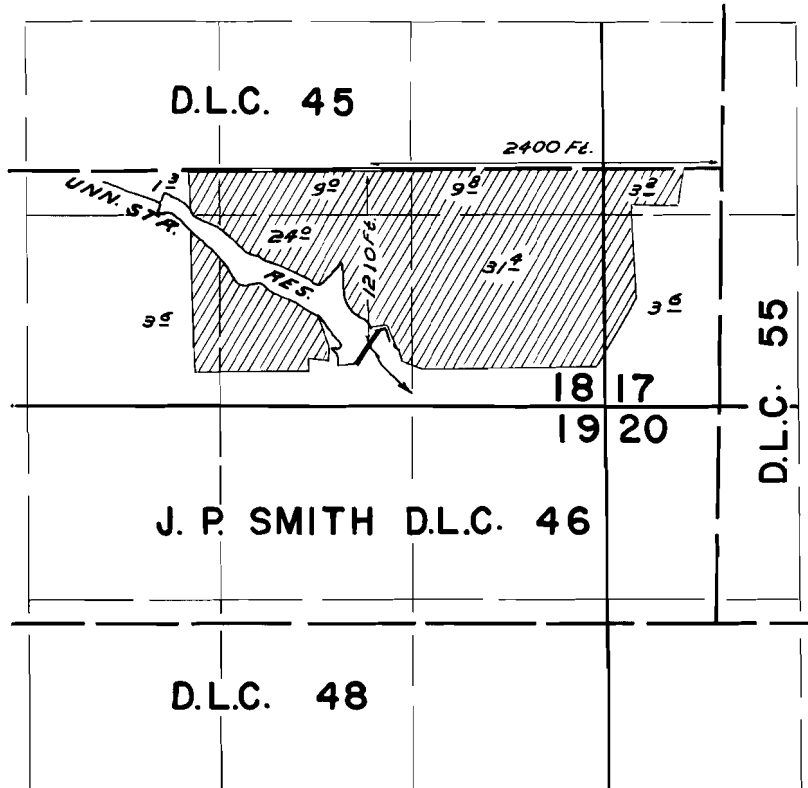

FINAL PROOF SURVEY
UNDER

R-38051

R-3195

Application No. 38052 Permit No. 28498
IN NAME OF

RUSSELL HILLS

Surveyed JULY 30 1965, by C. GARDNER